


Section 16 Township 16 Range 13-N

Well No. #2 Whittig

Company Phil-Han

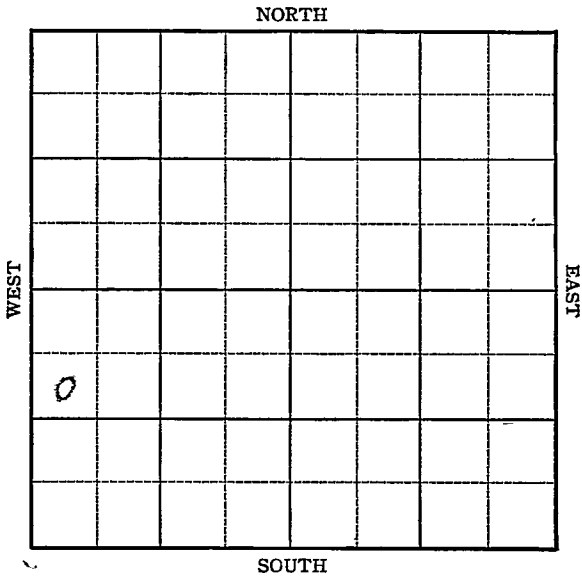

Sec. 16 Twp. 16 R. 13W

Well No. #2 Whittig Farm

Phil-Hen Company


Susank

990 Ft. from N. Line

_____ Ft. from S. Line

_____ Ft. from E. Line

330 Ft. from W. Line

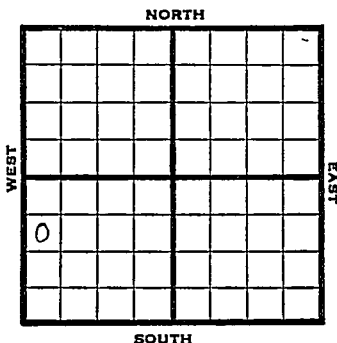

SW NW SW

1946 Elev. 1940' REPORT

1/23	8" @ 498' WOC
1/31	Anhy 890' Drig. 2815'
2/7	Lans. 3186' Arb. 3397-98' T.D. 5" - 3397' RUST.
2/14	" " "
2/21	T.D. 3401' Pump 100 oil per day.
2/28	Pump 100 oil a day.
3/6	Arb. 3397 5" @ 3397 TD 3401' Pump 103 Pot. Grav. 39.0

COMPLETED

"

KANSAS

Kansas Pool Name Susank

Map No. 73 Sec. 16 Twp. 16 R. 13W

Well No. 2Whittig

Phil-Han Company

COMPLETED

Contractor

SW NW SW

E. 1940
SECTION PLAT

990 Ft. from N. Line

_____ Ft. from S. Line

_____ Ft. from E. Line

330 Ft. from W. Line

0			

Barton County

Location _____

Rig up _____

Drilling and Remarks:

Cur 83897
5' 23397
Pump 103 1st

29 2/4

RECORD

Cased _____ in., _____ ft.

Sand _____

Gas _____

Oil _____

Total Depth 2401

PRODUCTION

1st 24 hrs. Nat. _____

1st 24 hrs. after shot _____

Gas _____ Cu. Ft.

Dry Hole _____

Abandoned _____

Date

MAR 6 1946 19

S. J. LEWIS Scout