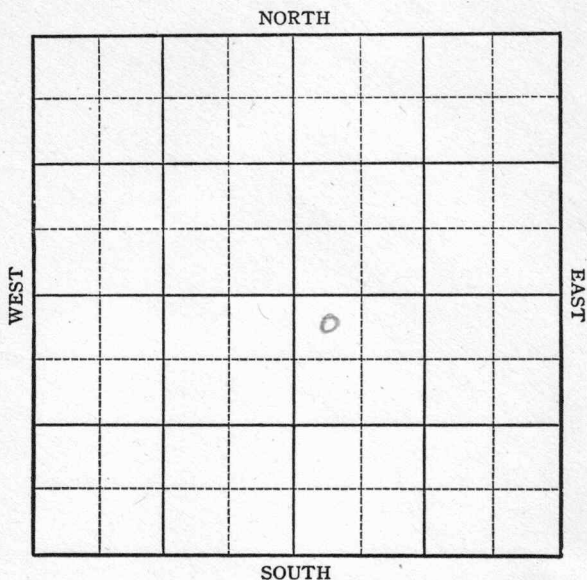


KANSAS

Russell county

FORM 51 5M 6-46 PETROL

Section 36 Township 14 Range 13-WWell No. #2, RubyCompany Harry Gore


KANSAS

Russell ✓

Sec. 36 Twp. 14 R. 13^W

Well No. 2 Ruby Farm
Harry Gore Company

330 Ft. from N. Line
Ft. from S. Line
Ft. from E. Line
330 Ft. from W. Line

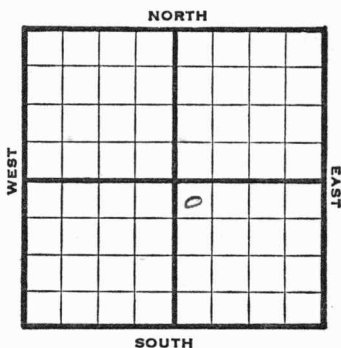

NW SE

REPORT	
1946	Elev. 1716
11/27	Location
12/3	Rig
12/10	"
12/17	"
1947	
1/4	15" @ 70' Drlg 375'
1/8	12" @ 370' Anhy 642' 10" @ 650' Drlg 660'
1/15	Drlg 1765'
1/21	8" @ 2280 Drlg 2430'
1/30	Topeka 2550 Lans 2872 Drlg 3025'
2/5	Arb 3154-56 TD 3156' 5" @ 3155 WOC
2/12	TD 3160' 1600' oil & 500' water


OVER

Kansas

Map No. 72 Sec. 36 Twp. 14 R. 13WWell No. 2 RubyHarry Gore CompanyFIRST REPORT Contractor

NW SE

SECTION PLAT

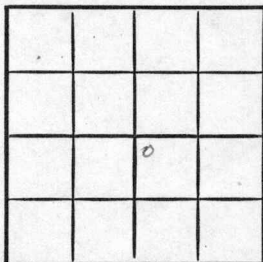330 Ft. from N. Line Ft. from S. Line Ft. from E. Line330 Ft. from W. LineRussell CountyLocation XRig up

Drilling and Remarks:

RECORD

Cased in., ft.Sand Gas Oil Total Depth

PRODUCTION

1st 24 hrs. Nat. 1st 24 hrs. after shot Gas Cu. Ft.Dry Hole Abandoned

Date

NOV 27 1946

19

S. J. LEWIS Scout

Kansas


Map No. 72 Sec. 36 Twp. 14 R. 13WWell No. 2 RubyHarry Gore

Company

COMPLETE

Contractor

NW SE

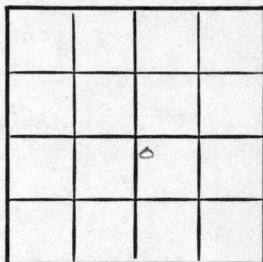E11716
SECTION PLAT330 Ft. from N. Line

Ft. from S. Line

Ft. from E. Line

330 Ft. from W. LineRussell County

Location

Rig up

Drilling and Remarks:

Cr 81545" @ 3155Pump 124 oil +42% W 80Y39 1/2

RECORD

Cased _____ in., _____ ft.

Sand _____

Gas _____

Oil _____

Total Depth 3160

PRODUCTION

1st 24 hrs. Nat. _____

1st 24 hrs. after shot _____

Gas _____ Cu. Ft.

Dry Hole _____

Abandoned _____

Date

FEB 26 1947

19

S. J. LEWIS

Scout

2/19 Pump 100 bbls oil & 40 W a day

2/26 Arb 3154'
5" @ 3155
Pump 124 oil & 42% W Pot
39.9 Grav.
TD 3160'

COMPLETED