

O.W.W.O.

KANSAS


Russell

Section 36 Township 14 Range 13-W

Well No. #2 Ruby

Company Shell

(Hall Gurney)

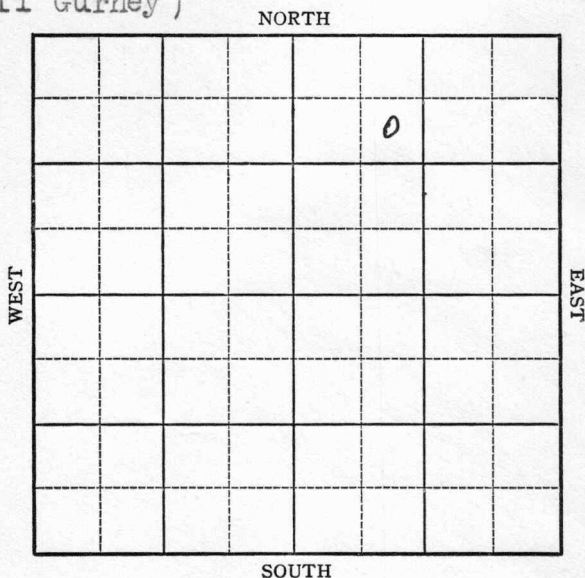

KANSAS

Russell

Sec. 36 Twp. 14 R. 13-W

Well No. #2 Ruby Farm

Shell

Company

(Hall Gurney)

O.W.W.O.


990 Ft. from N. Line

_____ Ft. from S. Line

_____ Ft. from E. Line

990 Ft. from W. Line

Elev. 1680

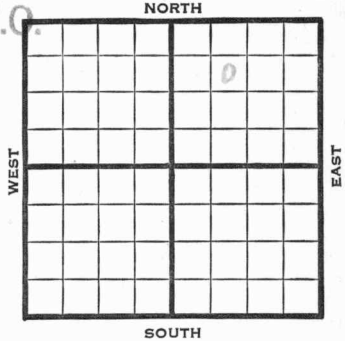

1941

REPORT

12/10 Location.

12/18 8" @ 615 WOC

12/24 Drlg. 2584'

12/31 Topeka 2423' Lans. 2816'

S.O. 2854-56' Arb. ~~3149-50'~~ ^{3106'} T.D.

Run 4" .

1942

1/8 Arb. 3106' (Corrected)

4" - 3150' T.D. 3158'

12 shots 3116-21½'

12 " 3119-26'

12 " 3121-26'

Swab 157 oil & 146 water.

OVER

1942
1/14

Arb. 3106'

4" - 3150'

T.D. 3150'

24 shots 3116-26'

12 " 3119-26'

Depthograph potential 1971 oil
& 794 water.

38. Gravity

COMPLETED

O.W.W.O.

1950

9/13

Lans 2816' Arb 3151'

OTD 3158'

4" @ 3158' SP 2950'

44/2914-25 1000 A

S/3½ BO 19 BW 5 hrs

2000 A S/2 BO 18 BW 3 hrs

PB 2895 133/2839-72

2000 A S/20 BO 3 BW 4 hr.

P & F/98 BO 37 BW 21 hr.

Comp. 66 BO 7 BWPD

FIRST REPORT
COMPLETED

Map No. 72 Sec. 36 Twp. 14 R. 13W

Well No. 2 Ruby

Shell Company

FIRST REPORT Contractor

SE NW NE

SECTION PLAT

990 Ft. from N. Line

_____ Ft. from S. Line

_____ Ft. from E. Line

990 Ft. from W. Line

		o	

HALL GURNEY POOL

Location XX

Rig up _____

Drilling and Remarks:

RECORD

Cased _____ in., _____ ft.

Sand _____

Gas _____

Oil _____

Total Depth _____

PRODUCTION

1st 24 hrs. Nat. _____

1st 24 hrs. after shot _____

Gas _____ Cu. Ft.

Dry Hole _____

Abandoned _____

Date

DEC 10 1941

19

S. J. LEWIS

Scout

Russell

KANSAS

Map No. 72 Sec. 36 Twp. 14 R. 13W

Well No. 2 Ruby

Shell Company

COMPLETED Contractor

SE NW NE

SECTION PLAT

990 Ft. from N. Line

_____ Ft. from S. Line

_____ Ft. from E. Line

990 Ft. from W. Line

		•	

HALL GURNEY POOL

Location _____

Rig up _____

Drilling and Remarks:

Cut 3106

4" C 3150

24 hrs to 3116-26

12 " 3119-26

Depth 24 1971 oil

794 Water

350 Gr.

RECORD

Cased _____ in., _____ ft.

Sand _____

Gas _____

Oil _____

Total Depth 3150

PRODUCTION

1st 24 hrs. Nat. _____

1st 24 hrs. after shot _____

Gas _____ Cu. Ft.

Dry Hole _____

Abandoned _____

Date

JAN 14 1942 19

S. J. LEWIS Scout

O.W.W.O.

County Russell State Kansas

Sec. 36 (Blk. Twp.) 14 (Sur. Rge.) 13W Map No.

Operator Shell

Well No. 2 Farm Ruby

Elev. 1680 Location SE NW NE

990 Ft. From N Line NE
990 Ft. From W Line Quarter
 1st. Report SEP 13 1950
 Completion SEP 13 1950
 Remarks OWNO

FIRST REPORT COMPLETE

Spudding Date _____

Drlg. Data Oil well Hall-Gurney Pool

Lans. 2816 Arb. 3151 OTD 3158
4" @ 3158 SP 2950 44/ 2914-25 1000 A
S/ 3 1/2 bo 19 bw 5 hr. 2000 A S/ 2 bo
18 bw 3 hr. PB 2895 133/ 2839-72
2000 A S/ 20 bo 3 bw 4 hr.
P & F/ 98 bo 37 bw 21 hr.
Comp. 66 bo 7 bwpd

J. E. TYRA