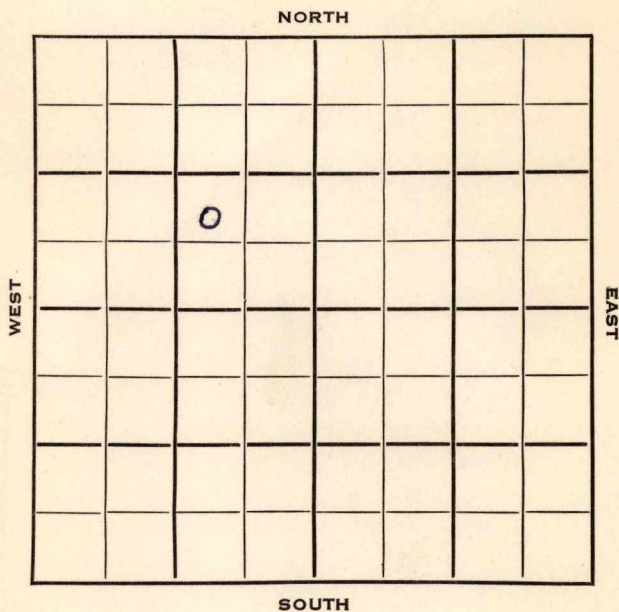


Section 30 Township 15 Range 17WWell No. 3 LeikerCompany N C R A

Ellis

KANSAS

SEC.

TWP.

R.

30

15

17W

WELL NO.

#3 Leiker

FARM

COMPANY

N.C.R.A.

CONTRACTOR

Isern Drlg.

SW Wheatland Pool

* NORTH

Ft. from N. Line

990

Ft. from S. Line

990

Ft. from E. Line

Ft. from W. Line

WEST

EAST

NW SE NW

SOUTH

	ELEVATION	REPORT
1953	1971'	
9/16	M I R	
9/23	8" @ 119	Anhy 1115 Lans 3252
	DST 3270-80 2 hrs,	200' oil, 120' SW
	1050#	
	DST 3287-3329	
12/9	Spud 9-14-53	Oil well TD 3589'
	8" @ 119	Anhy 1115 Heeb 3203
	Tor. 3219	Lans 3252
	DST 3270-80 open 2 hr	rec 200' oil
	120' SW	1050#
	DST 3287-3329 open 2 hr	rec 1140'
	GCO & wtr.	1050#
	DST 3323-29 open 2 hr,	rec 1020' gas,
	90' HO & GCM	1085#
	DST 3401-24 open 2 hr	rec 120' G &
	OCM, 240' oil, 1050#	Cong. 3516'
	Arb. 3530'	
	DST 3531-53 open 2 hr	rec 40' mud 0#
	DST 3535-60 open 2 hr	rec 25' OCM,
	25' mud	840#
	DST 3562-77 open 2 hr	rec 90' SW
	990#	TD 3589 5" @ 3588
	CO to 3589	
	32/3552-59	FU 3 GO 9 hr.
	30/3559-64	250 A 63 GO 9 hr.
	1000 A	FU 1150' oil 1350' wtr.
	24 hr.	

1953
12/9

(Information continued)

S/8 $\frac{1}{2}$ BFPH 70% wtr. PB 3558

S/3-3/4 BFPH 38% wtr. 13 hr.

PB 3480 44/3418-28 500 A

FU 1107' fluid 9 hr. S/60 BF 7 hr.

20% wtr. P/98 BO 3% wtr. 10 hr.

Comp. 321 BOPD

COMPLETED

County **Ellis** State **Kansas**

Sec. 30 (Blk. Twp.) 15 (Sur. Rge.) 17W Map No.

Operator N C R A

Well No. 3 Farm Leiker

Elev.	Location	NW SE NW
-------	----------	----------

0

FIRST REPORT

990 Ft. From S Line NW

990 Ft. From ~~P~~ Line Quarter

1st. Report SEP 16 1953

Completion

Remarks

Isern Drlg. - Contr.

Spudding Date _____

Drig. Data SW Wheatland Pool


M I R

County Ellis State Kansas
 Sec. 30 (Blk.) 15 (Sur.) 17W Map No.

Operator N C R A

Well No. 3 Farm Leiker

Elev. 1971 Location NW SE NW

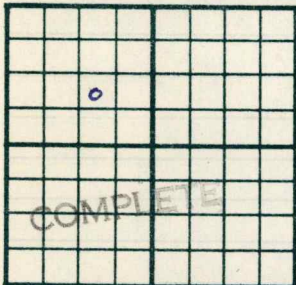

990 Ft. From S Line NW

990 Ft. From E Line Quarter

1st. Report

Completion DEC 9 1953

Remarks SW Wheatland Pool

Isern Drlg. - Contr.

Spudding Date 9-14-53

Drlg. Data Oil well TD 3589

8" @ 119 Anhy 1115 Heeb. 3203

Tor. 3219 Lans. 3252 DST 3270-80

open 2 hr. Rec. 200' oil 120' sw 1050#

DST 3287-3329 open 2 hr. Rec. 1140' gco

& wtr. 1050# DST 3323-29 open 2 hr.

Rec. 1020' gas 90' ho & gcm 1085#

DST 3401-24 open 2 hr. Rec. 120' g & ocm

240' oil 1050# Cong. 3516 Arb. 3530

DST 3531-53 open 2 hr. Rec. 40' mud

0# DST 3535-60 open 2 hr. Rec.

25' ocm 25' mud 840# DST 3562-77

open 2 hr. Rec. 90' sw 990# TD 3589

5" @ 3588 CO to 3589 32/ 3552-59

FU 3 go 9 hr. 30/ 3559-64 250 A

J. G. McGEHEE

Drlg. Data

63 go 9 hr. 1000 A FU1150' oil
1350' wtr. 24 hr. S/ $8\frac{1}{2}$ bfph 70% wtr.
PB 3558 S/ $3\frac{3}{4}$ bfph 38% wtr. 13 hr.
PB 3480 44/ 3418-28 500 A FU 1107'
fluid 9 hr. S/ 60 bf 7 hr. 20% wtr.
P/ 98 bo 3% wtr. 10 hr.
Comp. 321 bopd

1953
DEC 16 9 17 220

