


Section 30 Township 15 Range 17W

Well No. 4 Leiker

Company N C R A

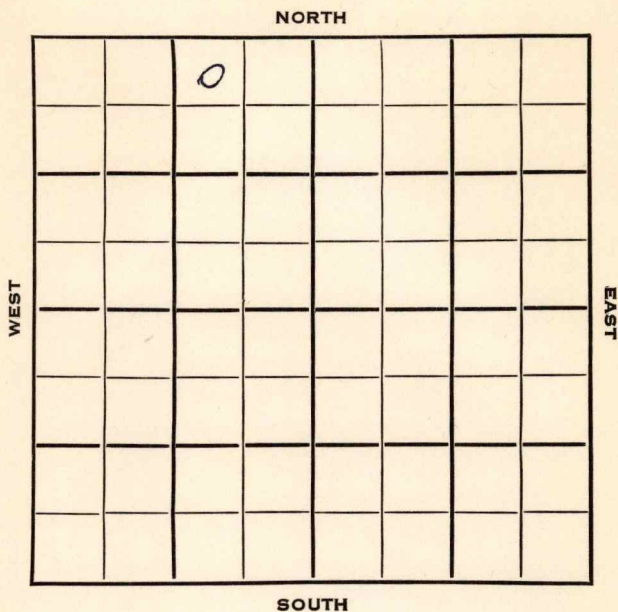

SEC.	TWP.	R.
30	15	17W ✓

WELL NO. **4 Leiker** FARM

COMPANY **N C RA**

CONTRACTOR **Lewis Drlg.**


SW Wheatland Pool

330 Ft. from N. Line

_____ Ft. from S. Line

990 Ft. from E. Line

_____ Ft. from W. Line

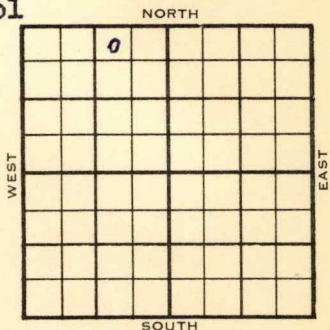

NW NE NW

	ELEVATION	REPORT
1953	1982'	

12/9 Spud 12-8-53
 12/16 Anhy 1143' 8" @ 1150'
 Drlg. 3130'

1954
 1/27 Spud 12-8-53
 Oil Well
 TD 3600'
 Anhy 1143'
 8" @ 1150'
 Heeb 3215',
 DST 3150'-72' opn 2 hr, rec 210' wtr
 870# Lans 3264'
 DST 3283'-97' opn 2 hr, rec 60' g &
 ocm, 240' gassy oil, 225' sw, 1130#
 DST 3410'-44' opn 2 hr, rec 90' vho &
 gcm, 480' gassy oil, 900# Arb 3523'
 TD 3600'
 5" @ 3600'
 CO to 3592'
 6/ 3569-70 S/ 40 go 2 hr. 54/ 3560-
 69 FU 200' oil 4 hr. 250 A S/ 75 bo
 5 hr.
 Comp 420 bopd.

COMPLETED

