

Ellis


KANSAS

SECTION 31 TOWNSHIP 15 RANGE 17W

WELL NO. #1 Dinkel "C"

COMPANY CRA

NORTH

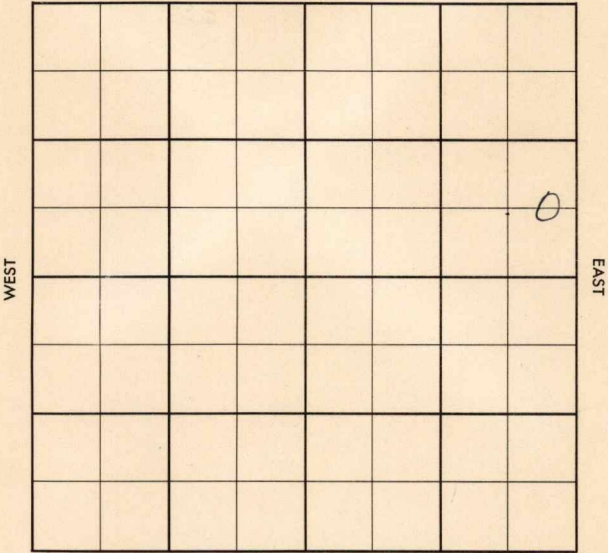

SOUTH

WILDCAT

FORM 513 SUNRAY

County Ellis Elev. 1907
Sec. 31 Twp. 15 Rge. 17W
Company CRA
Farm Name Dinkel "C" No. 1

TOPS	DEPTH	LOG	DATUM	Loc. in Sec.
Anh.				E/2 SE NE
TP.				App. 2050' fnl
H.				x 330' fel
Tr.				
Dg.				
Bl.				
L.				Geol. _____
K.C.				Contr. _____
B.K.C.				
Ce.				Shields Tools
C.				Pool w heatland
M.				Wildcat
M.				
K.				
Mz.				
Me.				
V.				
S.				
S.				
A.				
R.				
PE.				
G.				
T.D.				

FIRST REPORT
DEC 23 1956

Date Comm. 12-22-56 NCRA FO

13" @ 305 w/300, WOC

~~14~~

Co.
Use.
No.
Sec.
T.
R.

County Ellis Elev. 1907 Co.
 Sec. 31 Twp. 15 Rge. 17W
 Company C R A
 Farm Name Dinkel "C" No. 1

TOPS	DEPTH	LOG	DATUM	Loc. in Sec.
Anh.	1054			E/2 SE NE
Tp.	2873			App. 2050' fnl
H.	3156			330' Tel
Tr.	3125			
Dg.				
Bl.				
L.	3208			Geol.
K.C.				Contr.
B.K.C.				
Ce.				
C.	3460			Shields Tools
M.				Pool wheatland
M.				Wildcat
K.				
Mz.				
Ma.				
V.				
S.				
S.				
A.	3500			
R.				
PE.				
G.				
T.D.	3550			

ABANDONED
 JAN 23 '57

Date Comm. 12-22-56 NCRA FO.
13" @ 305 w/300, WOC JAN 2 '57 Rng 8"
JAN 9 '57 @ 1065/450 @ 2125
JAN 15 '57 DST 3215-61 1hr 19'
WCM BHP 0/20" DST 3427-78
45" 20' Md All press 0/20" @
3485 JAN 23 '57 DST 3503-09 @ 45"
34' Md BHP 485

D&A