

KANSAS


Barton

Form 51-5M-7-40-Palace

Section 17 Township 16 Range 13-W

Well No. #1 Miller

Company Wakefield

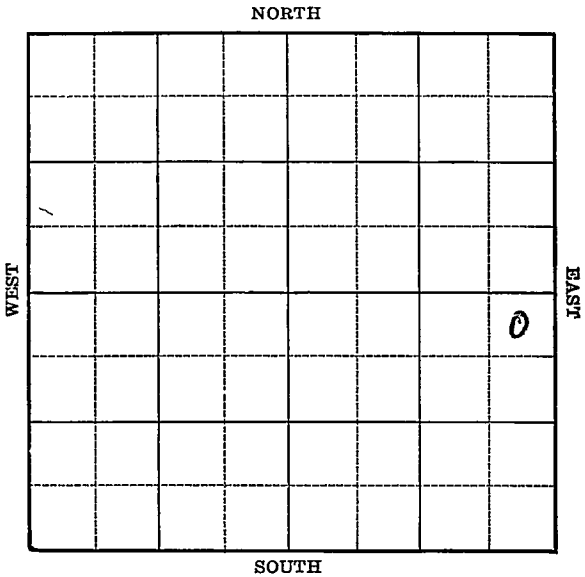

Map No. 73 Sec. 17 Twp. 16 R. 13WWell No. 1 MillerWakefield Company~~COMPANIES~~

Contractor

SECTION PLAT

NE SE

330 Ft. from N. Line

_____ Ft. from S. Line

330 Ft. from E. Line

_____ Ft. from W. Line

TRAPP POOL

| | | | |
|--|--|--|---|
| | | | |
| | | | |
| | | | o |
| | | | |

Location _____

Rig up _____

Drilling and Remarks:

*As 8 3395-**5" 08395**3000 cu ft**Depth 2222 P.S.**39^e Gr.*

RECORD

Cased _____ in., _____ ft.

Sand _____

Gas _____

Oil _____

Total Depth 3400

PRODUCTION

1st 24 hrs. Nat. _____

1st 24 hrs. after shot _____

Gas _____ Cu. Ft.

Dry Hole _____

Abandoned _____

Date

FEB 5 1941 19S. J. LEWIS Scout