

Section 28 Township 13 Range 17W

Well No. #1 Dreiling

Company Glenn Nye et al

NORTH

							0

9

WEST

EAST

SOUTH

Ellis

KANSAS

Sec. 28 Twp. 13 R. 17W

Well No. #1 Dreiling Farm

Glenn Nye et al Company

Contractor


330' Ft. from N. Line

Ft. from S. Line

330' Ft. from E. Line

Ft. from W. Line

NE NE SE

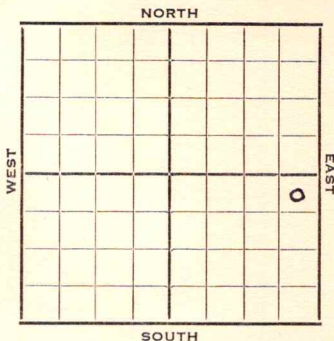

1952 Elev. 1957' REPORT

3/15 Spud 3-15-52
8" @ 95
Drlg. 1170'

3/25 Anhy 1175 SD @ 3082'

4/1 Heeb. 3195 Tor. 3213
Lans. 3236
DST 3256-72 45 mins. 30' SOCM
200 # B KC 3468 Arb. 3480
DST 3482-3507 RTD 1/2 hr.
1520' oil no wtr. 800# Sch.
5" @ 3482' WOC

4/9 DP CO to 3507 s/ 32 BOPH 800'
off btm. tstg.

4/23 "

4/30 "

5/7 NR

5/14 NR

5/21 "

5/28 Spud 3-15-52
Oil well TD 3507' 8" @ 95
Anhy 1175' Heeb 3195' Tor. 3213'
Lans. 3236'
DST 3256-72 open 45 min, rec 30' SOCM
B KC 3468' Arb. 3480'
DST 3482-3507 open 1/2 hr. rec 1520' oil
no water. 5" @ 3482' TD 3507'
S/32 BOPH Comp. 518 BOPD

COMPLETED

County **Ellis** State **Kansas**

Sec. **28** (Blk. Twp.) **13** (Sur. Rge.) **17W** Map No.

Operator **Glenn Nye etal.**

Well No. **1** Farm **Dreiling**

Elev. Location **NE NE SE**

FIRST REPORT

330 Ft. From **N** Line **SE**

330 Ft. From **E** Line Quarter

Ist. Report **MAR 19 1952**

Completion

Remarks

Spudding Date **3-15-52**

Drlg. Data

8" @ 95 drlg. 1170

