


Section 36 Township 14 Range 13W

Well No. 3 Ruby "B"

Company Harry Gore

Russell County- Hall-Gurney  
NORTH Pool

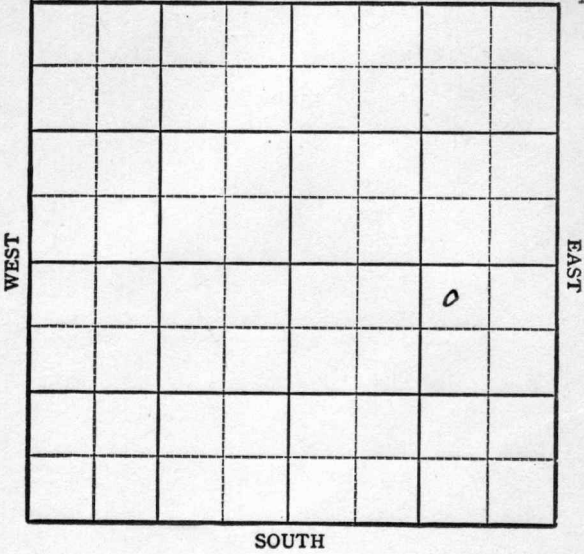

Sec. 36 Twp. 14 R. 13-W ✓


Well No. #3 Ruby "B" Farm  
Harry Gore Company  
Hall-Gurney

330 Ft. from N. Line

\_\_\_\_\_ Ft. from S. Line

990 Ft. from E. Line

\_\_\_\_\_ Ft. from W. Line

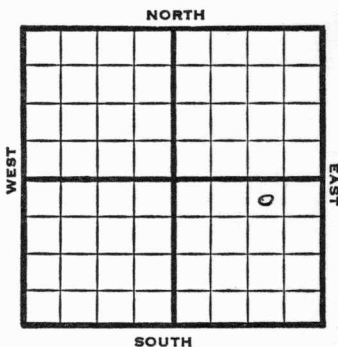

NW NE SE

1948 Elev 1696' REPORT

12/22	Rig
12/29	"
1/5	"
1/12	10" @ 686 Drlg 715
1/19	Drlg 1785'
1/26	8"@ 2290' DBlg 2315'
2/2	Drlg. 2670'
2/9	Topeka 2535' Lansing 2862' Drlg 2865'
2/16	2
2/23	TD 3195'
3/2	TD 3197' Arb. 3153' Aband.

**ABANDONED**

Map No. \_\_\_\_\_ Sec. 36 Twp. 14 R. 13W

Well No. 3 Ruby "B"

Harry Gore Company

**FIRST REPORT**

Contractor

NW NE SE

**SECTION PLAT**

330 Ft. from N. Line

\_\_\_\_\_ Ft. from S. Line

990 Ft. from E. Line

\_\_\_\_\_ Ft. from W. Line

			o

Russell County

Location \_\_\_\_\_

Rig up \_\_\_\_\_

Drilling and Remarks:

Rig

**RECORD**

Cased \_\_\_\_\_ in., \_\_\_\_\_ ft.

Sand \_\_\_\_\_

Gas \_\_\_\_\_

Oil \_\_\_\_\_

Total Depth \_\_\_\_\_

**PRODUCTION**

1st 24 hrs. Nat. \_\_\_\_\_

1st 24 hrs. after shot \_\_\_\_\_

Gas \_\_\_\_\_ Cu. Ft.

Dry Hole \_\_\_\_\_

Abandoned \_\_\_\_\_

Date

DEC 22 1948 19

S. J. LEWIS

Scout

Kansas

Map No. 72 Sec. 36 Twp. 14 R. 13WWell No. 3 Ruby "B"Harry Gore Company**ABANDONED**

Contractor

NW NE SE

*E11696*  
SECTION PLAT330 Ft. from N. Line         Ft. from S. Line990 Ft. from E. Line         Ft. from W. Line

			o

Russell County

Location \_\_\_\_\_

Rig up \_\_\_\_\_

Drilling and Remarks:

*See 73153*

## RECORD

Cased \_\_\_\_\_ in., \_\_\_\_\_ ft.

Sand \_\_\_\_\_

Gas \_\_\_\_\_

Oil \_\_\_\_\_

Total Depth 3192

## PRODUCTION

1st 24 hrs. Nat. \_\_\_\_\_

1st 24 hrs. after shot \_\_\_\_\_

Gas \_\_\_\_\_ Cu. Ft.

Dry Hole \_\_\_\_\_

Abandoned \_\_\_\_\_

Date

MAR 2 1949 19S. J. LEWIS Scout