

KANSAS


FORM 51 5M 6-46 PETROL

Barton County

Section 17 Township 16 Range 13W

Well No. #1 Bitters

Company B. & R. Drlg.

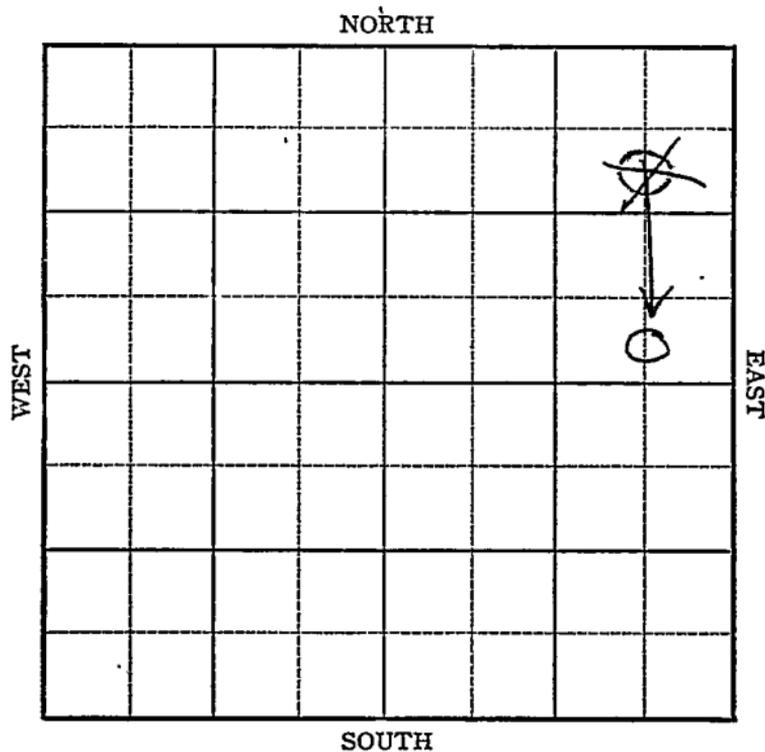

KANSAS

Barton County



Sec. 17 Twp. 16 R. 13W

Well No. #1 Bitters Farm _____

B. & R. Drlg. Company _____

Susank


~~990~~ Ft. from N. Line

330 Ft. from S. Line

660 Ft. from E. Line

_____ Ft. from W. Line

SE
CSL NE NE

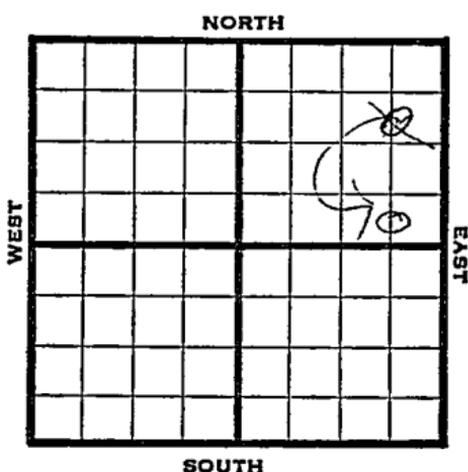

1946

1931

REPORT

- 7/10 Location
- 7/16 8" @ 551 WOC
- 7/23 Anhy 895
Drlg 2416'
- 7/30 Drlg 2938'
- 8/6 Lans 3147
Arb 3384-
TD 3386
5" @ 3385 RUST
- 8/13 TD 3389
2000 oil 2 hrs
- 8/21 Arb. 3384
5" @ 3385
TD 3389
Pump 136 oil plus 15% wtr. Pot.
Grav. 39.0

COMPLETED

KANSAS Kansas Pool Name SusankMap No. 73 Sec. 17 Twp. 16 R. 13WWell No. 1 BittersB. & R. Drlg. CompanyFIRST REPORT Contractor

C S L NE NE

SECTION PLAT

990 Ft. from N. Line Ft. from S. Line660 Ft. from E. Line Ft. from W. Line

Barton County

Location XRig up

Drilling and Remarks:

RECORD

Cased in., ft.Sand Gas Oil Total Depth

PRODUCTION

1st 24 hrs. Nat. 1st 24 hrs. after shot Gas Cu. Ft.Dry Hole Abandoned

Date

JUL 10 1946 19S. J. LEWIS Scout

~~SUSANK~~ Kansas Pool Name Susank

Map No. 23 Sec. 17 Twp. 16 R. 13W

Well No. 1 Butters

B & R Drlg. Company

~~CORRECTION~~ Contractor

C S L SE NE


SECTION PLAT

 Ft. from N. Line

330 Ft. from S. Line

660 Ft. from E. Line

 Ft. from W. Line

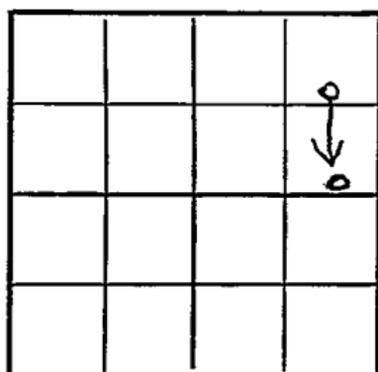

Barton County

Location

Rig up

Drilling and Remarks:

Reported
C S L NE NE

RECORD

Cased in., ft.

Sand

Gas

Oil

Total Depth

PRODUCTION

1st 24 hrs. Nat.

1st 24 hrs. after shot

Gas Cu. Ft.

Dry Hole

Abandoned

Date

JUL 17 1946 19 S. J. LEWIS Scout

KANSAS

Kansas

Pool Name Susank

Map No. 73 Sec. 17 Twp. 16 R. 13W

Well No. 1 Bitters

B & R Drlg. Company

COMPLETED

Contractor

C S L SE NE

E 11830
SECTION PLAT

 Ft. from N. Line

330 Ft. from S. Line

660 Ft. from E. Line

 Ft. from W. Line

			6

Barton County

Location

Rig up

Drilling and Remarks:

Pr 3384
5" 3385
Pump 136 oil
+ 15% Water
39° G

RECORD

Cased in., ft.

Sand

Gas

Oil

Total Depth 3384

PRODUCTION

1st 24 hrs. Nat.

1st 24 hrs. after shot

Gas Cu. Ft.

Dry Hole

Abandoned

Date

AUG 21 1946 19

S. J. LEWIS Scout