


KANSASSection 36 Township 14 Range 13WWell No. 2 WeinmeisterCompany El CapitanHall-Gurney

NORTH

WEST

EAST

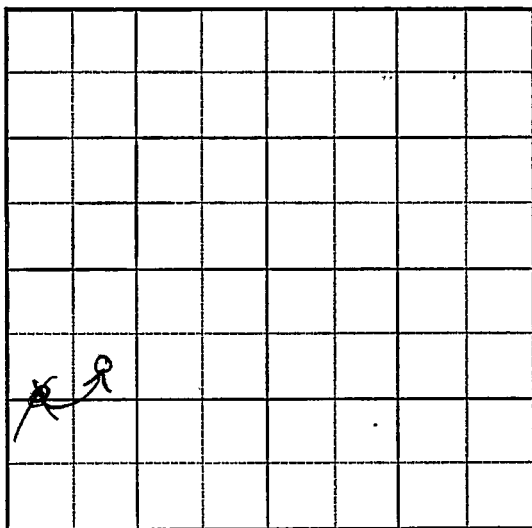

SOUTH

KANSAS

Russell

Sec. 36 Twp. 14 R. 13W ✓

Well No. #2 Weinmeister Farm

El Capitan Company


Hall-Gurney

990 Ft. from N. Line

1520 Ft. from S. Line

 Ft. from E. Line

990
330 Ft. from W. Line

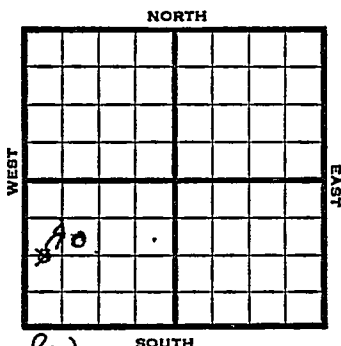

~~C W L SW~~ *SE NW SW*

1949 Elev 1729' REPORT

4/6 8" @ 300'
4/12 Lansing 2875-3075' Drlg
4/20 " "
4/27 " "
5/4 TD 3179'
Arb. 3175'
5" @ 3175'
Pump 50 Oil Pot
40' Gr.
Comp

COMPLETED

Map No. _____ Sec. 36 Twp. 14 R. 13W

Well No. 2 Weinmeister

El Capitan Company

FIRST REPORT

Contractor

C W L SW


SECTION PLAT

_____ Ft. from N. Line

1320 Ft. from S. Line

_____ Ft. from E. Line

330 Ft. from W. Line

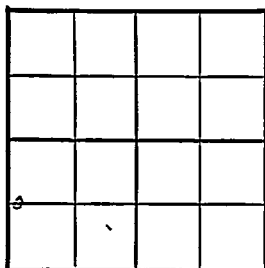

Russell County

Location _____

Rig up _____

Drilling and Remarks:

8" @ 300

RECORD

Cased _____ in., _____ ft.

Sand _____

Gas _____

Oil _____

Total Depth _____

PRODUCTION

1st 24 hrs. Nat. _____

1st 24 hrs. after shot _____

Gas _____ Cu. Ft.

Dry Hole _____

Abandoned _____

Date

APR 6 1949 19 S. J. LEWIS Scout

Map No. 72 Sec. 36 Twp. 14 R. 13W

Well No. 2 Weinmeister

El Capitan Company

CORRECTION Contractor

SE NW SW

SECTION PLAT

990 Ft. from N. Line

 Ft. from S. Line

 Ft. from E. Line

990 Ft. from W. Line

Russell County

Location

Rig up

Drilling and Remarks:

Reported
C W L SW

RECORD

Cased in., ft.

Sand

Gas

Oil

Total Depth

PRODUCTION

1st 24 hrs. Nat.

1st 24 hrs. after shot

Gas Cu. Ft.

Dry Hole

Abandoned

Date

APR 13 1949

19

S. J. LEWIS

Scout

Map No. K-72 Sec. 36 Twp. 14 R. 13W

Well No. 2 Weinmeister

El Capitan Company

COMPLETE

Contractor

SE NW SW

E. 1729
SECTION PLAT

990 Ft. from N. Line

_____ Ft. from S. Line

_____ Ft. from E. Line

990 Ft. from W. Line

Russell County

Location _____

Rig up _____

Drilling and Remarks:

Cer x 3125

5" C 8175

Run 50 oil Rod

40 3/4

RECORD

Cased _____ in., _____ ft.

Sand _____

Gas _____

Oil _____

Total Depth 2179

PRODUCTION

1st 24 hrs. Nat. _____

1st 24 hrs. after shot _____

Gas _____ Cu. Ft.

Dry Hole _____

Abandoned _____

Date

MAY 4 1949

19

S. J. LEWIS

Scout