


Section 34 Township 15 Range 17W

Well No. #1 ~~3~~ Jacobs

Company Anschutz Drlg

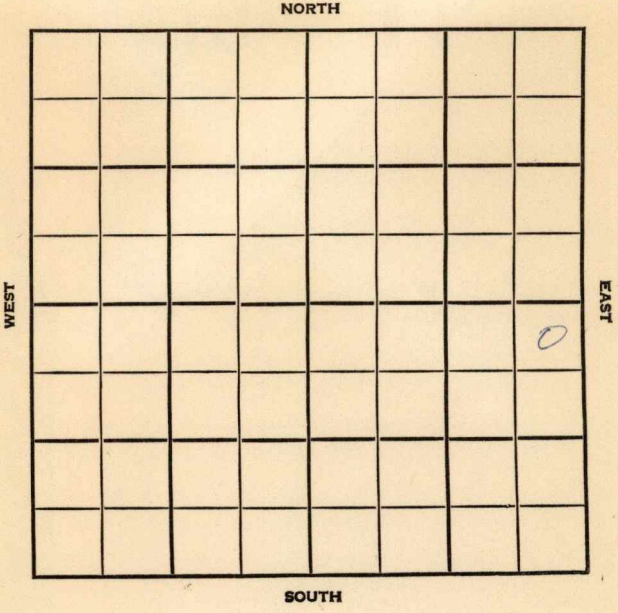

Ellis

KANSAS

SEC. 34	TWP. 15	R. 17W
------------	------------	-----------

WELL NO. #1 Jacobs FARM

COMPANY Anschutz Drlg.

CONTRACTOR Honaker-Davis

WILDCAT


_____ FT. FROM N. LINE

_____ FT. FROM S. LINE

_____ FT. FROM E. LINE

_____ FT. FROM W. LINE

NE NE SE

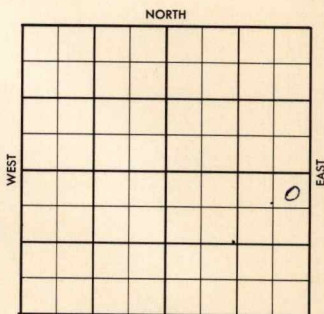

Amerada - DHM

1956	ELEVATION 1891'	REPORT
------	--------------------	--------

8-22 Comm. 8-12-56
8" @ 105 w/575
Drlg. 2795

8-29 DST 3354-90 op 30 min. rec. 60' mud,
FP 60-90#, BHP 110#.
DST 3483-91 op 30 min. rec. 15' mud,
BHP 640#
Log.
D & A
Tp. 2929'; H. 3156'; Tr. 3176';
L. 3205'; BKC 3440'; A. 3485';
TD 3520'

ABANDONED

Co.

County Ellis Elev. 1891
 Sec. 34 Twp. 15 Rge. 17W
 Company Anschutz Drlg.
 Farm Name Jacobs No. 1

TOPS	DEPTH	LOG	DATUM	Loc. in Sec.
Anh.				NE NE SE
Tp.	2929			
H.	3156			
Tr.	3176			
Dg.				
Bl.				
L.	3205			Geol.
K.C.				Contr.
B.K.C.	3440			Honaker-Davis
Ce.				
C.				
M.				Pool
M.				
K.				Wildcat
Mz.				
Me.				
V.				
S.				
S.				
A.	3485			ABANDONED
R.				
PE.				
G.				
TD.	3520			AUG 29 1956

Co.

No.

Sec.

T.

R.

Date Comm. 8-12-56 Amerada - DHM
8" @ 105/575 drlg. 2795 AUG 29 '56

DST 3354-90 30" rec 60' Md
FP 60-90 BHP 110 DST 3483
-91 30" rec 15' Md BHP 640
Log.

D & A.

Co.

County Ellis Elev. 1891
 Sec. 34 Twp. 15 Rge. 17W
 Company Anschutz Drlg.
 Farm Name Jacobs No. 1

TOPS	DEPTH	LOG	DATUM	Loc. in Sec.
Anh.				NE NE SE
Tp.				
H.				
Tr.				
Dg.				
Bl.				
L.				Geol.
K.C.				Contr.
B.K.C.				Honaker-Davis
Ce.				
C.				
M.				Pool
M.				Wildcat
K.				
Mz.				
Me.				
V.				
S.				
S.				
A.				
R.				
Pe.				
G.				
T.D.				

St.

No.

Sec.

T.

R.

Date Comm. 8-12-56 Amerada - DHM
8" @ 105/575 drlg. 2795

FIRST REPORT
 AUG 22 1956


