


Ellis

Section 25 Township 15 Range 18W

Well No. #1 Herl

Company Peel - Hardman

NORTH

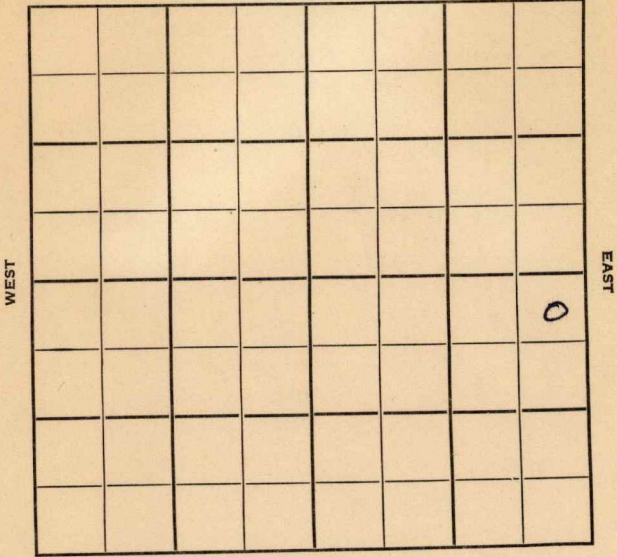

SOUTH

Ellis

KANSAS

Sec. 25 Twp. 15 R. 18 W

Well No. # 1 Herl Farm

Peel-Hardman Company

Peel Brothers Contractor


330 Ft. from N. Line

_____ Ft. from S. Line

330 Ft. from E. Line

_____ Ft. from W. Line

NE NE SE

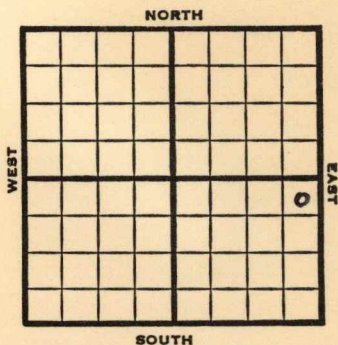

1953

Elev. 1955' REPORT

- 3/18 Cellar & Pits
- 3/26 C&P
- 4/2 "
- 4/9 "
- 4/16 "
- 4/23 **Anhy 1100'**
8" @ 1105
Drlg. 3150'
- 4/30 **Heeb 3209' Lans 3259 Cong 3523**
Arb. 3534'
DST 3535-40, 1/4 hr, 25' M 1055#
TD 3540 5" @ 3535
- 5/7 DD 3566 TD
S/ 10 boph 1100# S/3/4 Boph / trace
12 hrs.
- 5/21 NR
- 5/28 "
- 6/3 Spud 4-13-53 Oil well TD 3566
Anhy 1100 8" @ 1105 Heeb 3209
Lans 3259 cong 3523 Arb. 3534
DST 3535-40 open 1/4 hr. rec 25' mud
1055# TD 3540 5" @ 3535 DD 3566
S/10 BOPH 1100# S/3/4 BOPH
Comp. 25 BOPD

COMPLETED

County **Ellis** State **Kansas**

Sec. **25** (Blk.) **15** (Sur.) **18W** Map No.

Operator **Peel - Hardman**

Well No. **1** Farm **Herl**

Elev. Location **NE NE SE**

330 Ft. From **N** Line **SE**

330 Ft. From **E** Line **Quarter**

1st. Report **MAR 18 1953**

Completion

Remarks

Peel Bros. - Contr.

Spudding Date

Drig. Data

Cellar & pits



