


Section 28 Township 13 Range 17^W

Well No. 1 Bissing

Company Glen R. Nye

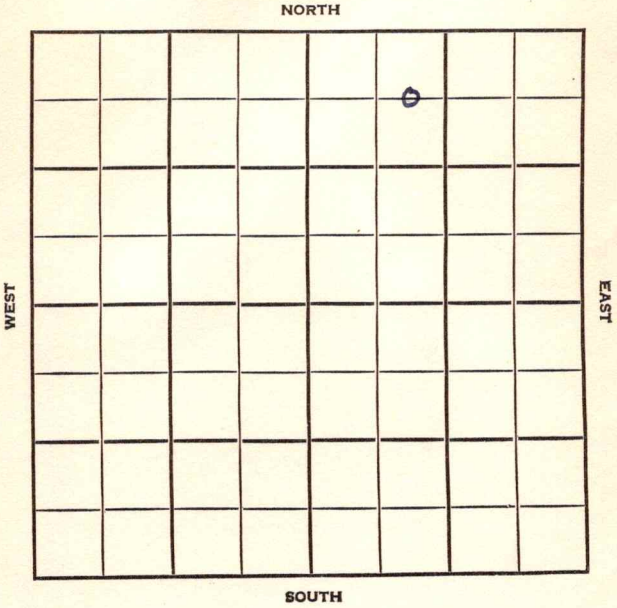

Ellis

KANSAS

SEC.	TWP.	R.
28	13	17W

WELL NO. #4 Bissing FARM

COMPANY Glen R. Nye

CONTRACTOR Co. Tools.

S. Catherine Pool


NORTH

660 Ft. from N. Line

Ft. from S. Line

Ft. from E. Line

990 Ft. from W. Line

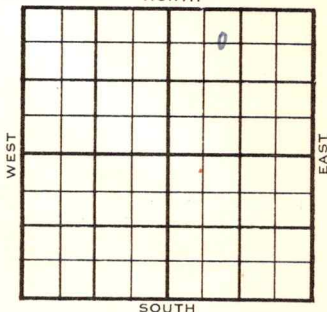

C E 1/2 NW NE

1955	ELEVATION 2002'	REPORT
------	--------------------	--------

1/26 M I R
 2/9 Spud 1-25-55
 D & A
 TD 3592'
 8-5/8" @ 123'
 Anhy 1218', Heeb 3244' Lans 3288'
 DST 3382'-90' opn 45 min, rec 16' Mud
 625# B KC 3513' Cong 3526'
 TD 3592'
 D & A

ABANDONED

County Ellis State Kansas

Sec. 28 (Blk.) 13 (Sur.) 17W Map No.

Operator Glen R. Nye

Well No. 4 Farm Bissing

Elev. 2002 Location C E $\frac{1}{2}$ NW NE

660 Ft. From N Line NE

990 Ft. From W Line Quarter

1st. Report

Completion FEB 9 1955

Remarks S. Catherine Pool

Co. tools

Spudding Date 1-25-55

Drlg. Data D & A TD 3592

8 5/8" @ 123 Anhy 1218 Heeb. 3244

Lans. 3288 DST 3382-90 open 45 min.

Rec. 16' mud 625# B KC 3513

Cong. 3526 TD 3592

D & A

FAREN GILSTRAP