


Barton

KANSAS

Form 51—5M—11-38—Palace

Section 17 Township 16 Range 13-WWell No. 1 H. MillerCompany Central & Vernon

Wildcat

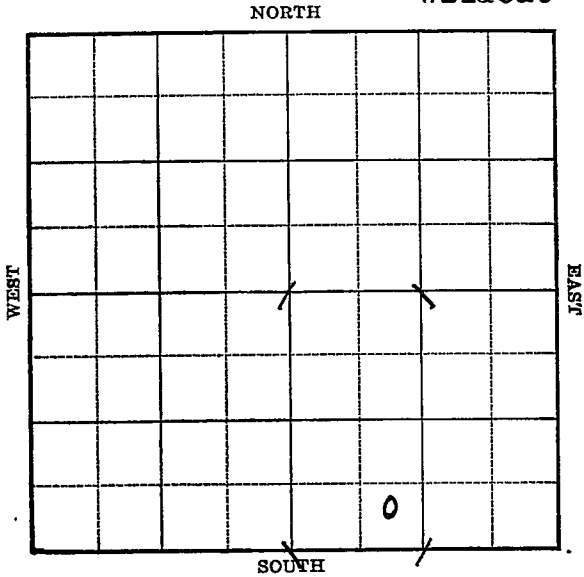


KANSAS**Barton**Sec. 17 Twp. 16 R. 13-WWell No. #1 H. Miller FarmCentral & Vernon

Company

(Wildcat) Ft. from N. Line440 Ft. from S. Line Ft. from E. Line990 Ft. from W. Line

Elev. 1956

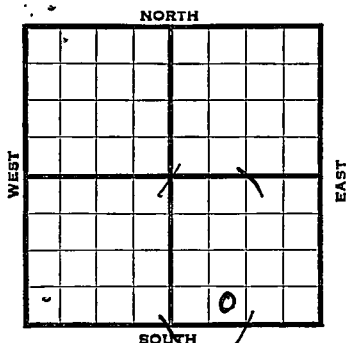

1939	REPORT
1/25	Mat'l.
2/3	B.C.R.
2/10	20" - 30'.
	Drlg. 340'.
2/17	15" - 486' Drlg. 685
2/23	Anhy 932' 12" - 937' Drlg. 1680
3/3	U. R. 8" - 2385'
3/10	8" - 2483' Drlg. 2525'
3/17	8" - 2640' Topeka 2875'
	Drlg. 2880'
3/24	Drlg. 2975'
3/31	Lans. 3184' 6" - 3225'
	S. W. 3275-80' S. O. 3315-25'
	Arb. 3418' T. D. 3425'
	200' oil 1 hour. C. O.
4/7	1800' oil total fill-up.
	5" - 3420' Drilled plug.
	3 bailers oil per hour.
	OVER

1939

4/14 1000 acid. Swab 1 oil & 4 water
per hour. Deepened to 3448'.
Inc. in water. S.D.O.

4/19 5" - 3420'
Arb. 3418'
T. D. 3448'
1000 acid.

ABANDONED

Barton

KANSAS

Map No. 73 Sec. 17 Twp. 16 R. 13WWell No. 1 H. MillerCentral & Vernon

Company

Contractor

C.S.O. F.O.

FIRST REPORT


SECTION PLAT

SE SW SE

Ft. from N. Line

440 Ft. from S. Line

Ft. from E. Line

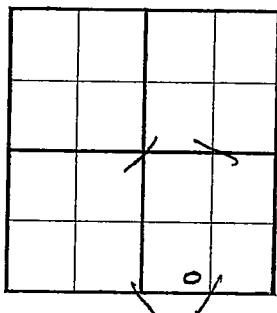990 Ft. from W. Line

WILDCAT

Location _____

Rig up _____

Drilling and Remarks:

Matl.

RECORD

Cased _____ in., _____ ft.

Sand _____

Gas _____

Oil _____

Total Depth _____

PRODUCTION

1st 24 hrs. Nat. _____

1st 24 hrs. after shot _____

Gas _____ Cu. Ft.

Dry Hole _____

Abandoned _____

Date

JAN 25 1939 19 H. D. Hatfield Scout

Barton

KANSAS

Map No. 73 Sec. 17 Twp. 16 R. 13WWell No. 1 H. MillerCentral & Vernon

Company

Contractor

ABANDONED

SECTION PLAT

SE SW SE

 Ft. from N. Line440 Ft. from S. Line Ft. from E. Line990 Ft. from W. Line

WILDCAT

		0	

Location Rig up

Drilling and Remarks:

1000 AcidD & A

RECORD

Cased 5 in., 3420 ft.Sand Arb 3418Gas Oil Total Depth 3448

PRODUCTION

1st 24 hrs. Nat. 1st 24 hrs. after shot Gas Cu. Ft.Dry Hole Abandoned

Date

27 1939 19 H. D. Hatfield Scout