


Section 28 Township 13 Range 17W

Well No. 1 Dreiling

Company Darby Petroleum

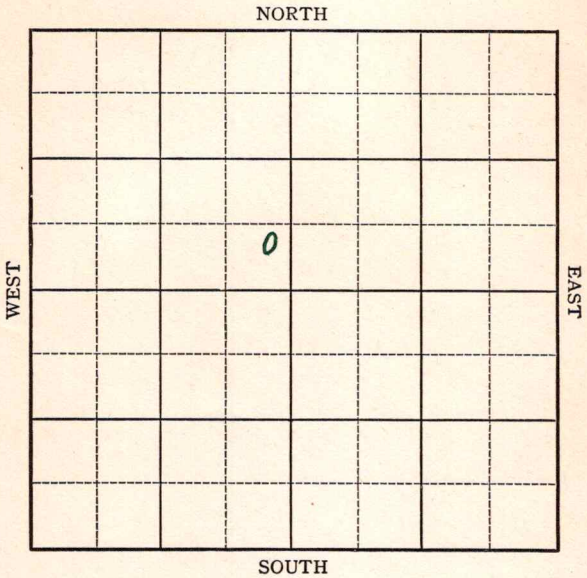

Sec. 28 Twp. 13 R. 17-W

Well No. #1 Dreiling Farm

Darby Petr. Company


(Wild cat)

_____ Ft. from N. Line

440 Ft. from S. Line

165 Ft. from E. Line

_____ Ft. from W. Line

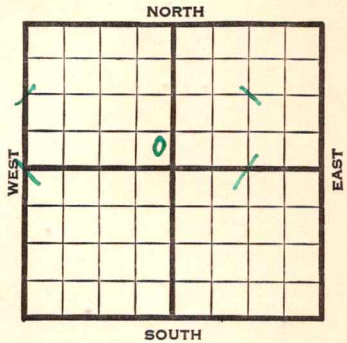

1941	REPORT
7/9	S. H.
7/17	10" - 1203' Drlg. 2000'
7/24	Topeka 3011 Lansing 3259 cong 3506 Arbu 3521-34 TD Run csg.
7/31	7" @ 3521 72 shots 3285-94 500 acid. No Help 1000acid Testing.
8/7	" " " " "
8/15	Drill Cement.
8/21	P.B. to 3400' 70 shots 3345-51 1000 acid. 500' water 5 hours.
8/28	Pump 272 oil & 136 water. Plug 3338' 60 shots 3312-20' 2000 acid.
9/4	" "

OVER

725071

1941
9/10

Lans. 3259'

Arb. 3521'

7" - 3521'

T.D. 3534'

71 shots 3285-94'

60 " 3345-51'

60 " 3312-20'

2500 acid.

Potential 352 oil plus 144 water,
on pump.

33.2 Gravity

COMPLETED

Ellis

KANSAS

Map No. _____ Sec. 28 Twp. 13 R. 17W

Well No. 1 Dreiling

Darby Petroleum Company

Contractor

FIRST REPORT

SECTION PLAT


SE NW

Ft. from N. Line

440 Ft. from S. Line

165 Ft. from E. Line

Ft. from W. Line

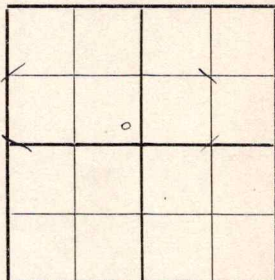

WILDCAT

Location _____

Rig up _____

Drilling and Remarks:

S. H.

RECORD

Cased _____ in., _____ ft.

Sand _____

Gas _____

Oil _____

Total Depth _____

PRODUCTION

1st 24 hrs. Nat. _____

1st 24 hrs. after shot _____

Gas _____ Cu. Ft.

Dry Hole _____

Abandoned _____

Date

JUL 9 1941

19

S. J. LEWIS

Scout

Map No. _____ Sec. 28 Twp. 13 R. 17W

Well No. 1 Dreiling

Darby Petroleum Company

COMPLETED Contractor

SECTION PLAT

SE NW

_____ Ft. from N. Line

440 Ft. from S. Line

165 Ft. from E. Line

_____ Ft. from W. Line

		o	

WILDCAT

RECORD

Location _____

Cased _____ in., _____ ft.

Rig up _____

Sand _____

Drilling and Remarks:

Gas _____

Oil _____

Total Depth 3534

PRODUCTION

1st 24 hrs. Nat. _____

1st 24 hrs. after shot _____

Gas _____ Cu. Ft.

Dry Hole _____

Abandoned _____

Liame 3259
Ac 89521
7" @ 3521
7 inch to 3255-94
60 " 3345-51
60 " 3312-20
2500 acid
Pump 352 oil + 144 water
332 Sr

Date

SEP 10 1941 19

S. J. LEWIS Scout