


Section 28 Township 13 Range 17W

Well No. #1 Dreiling

Company Brooks-Pierce

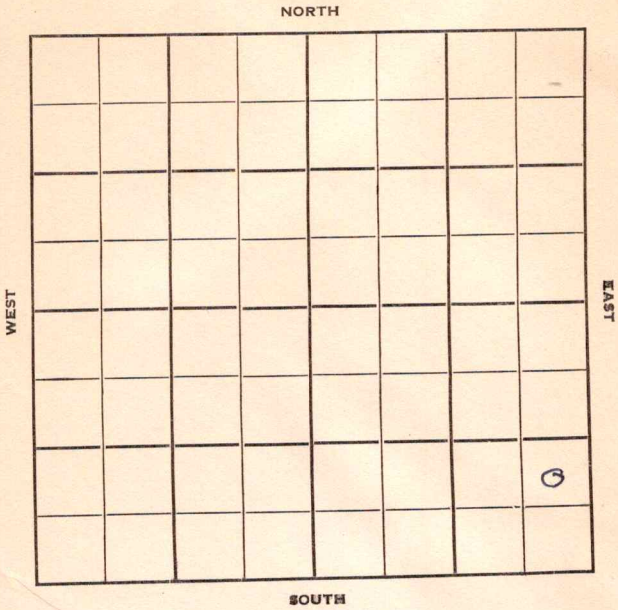

Sec. 28 Twp. 13 R. 17 W

Well No. # 1 Dreiling Farm

Brooks-Pierce Company

Braden Drlg. Contractor

Sugar Loaf Pool


Ft. from N. Line

990 Ft. from S. Line

330 Ft. from E. Line

Ft. from W. Line

NE SE SE

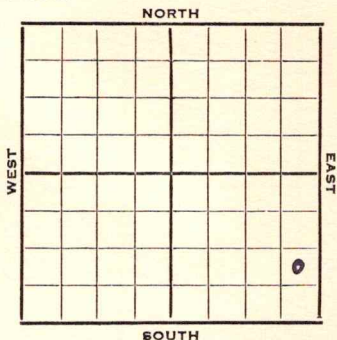

1952 **Elev. 1958'** REPORT

- 10/15 Spud 10-10-52  
8" @ 160 **Anhy 1155'**  
Drlg. 1810'
- 10/22 **Lans 3230**  
DST 3297-3321, 1 hr., 90' OCM  
710#  
Drlg. 3425'
- 10/29 DST 3251-71, 1 hr, 15' M 645#  
**Arb. 3477'** RTD 3483' 5" @ 3479'
- 11/5 CO 3485'
- 11/12 NR
- 11/20 NR
- 11/26 Spud 10-10-52 D & A TD 3485'  
8" @ 160 **Anhy 1155'** **Heeb 3191'**  
**Lans. 3230'**  
DST 3297-3321 open 1 hr. rec 90' OCM  
710#  
DST 3251-71 open 1 hr. rec 15' mud  
645# **Arb. 3477'** TD 3483 5" @ 3479  
CO to 3485 Pipe caved Lost hole.  
D & A  
**ABANDONED**



