


Section 28 Township 13 Range 17 W

Well No. # 3 Dreiling "A"

Company Brooks Pierce Drlg.

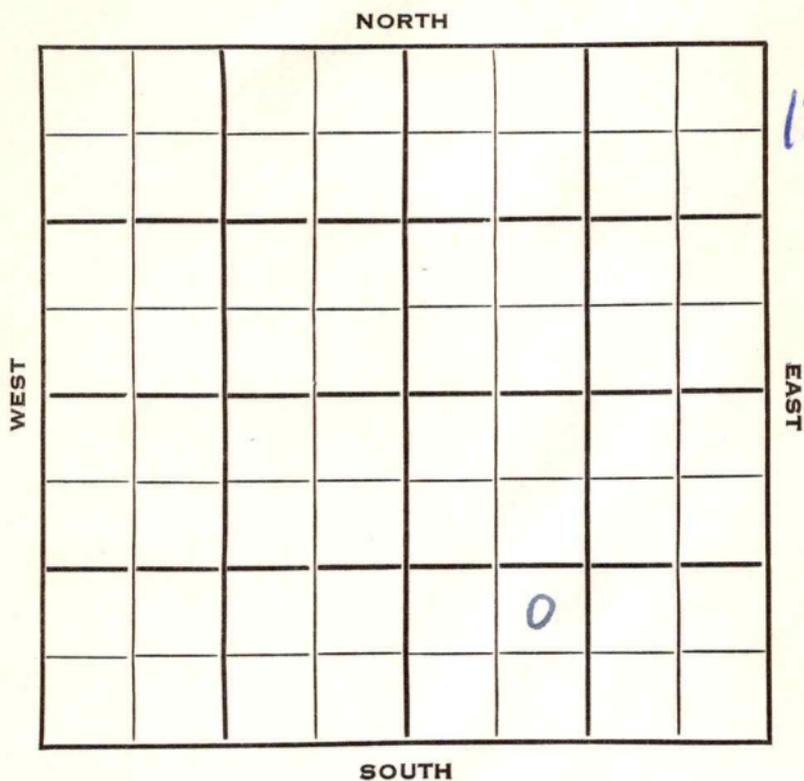

SEC. 28	TWP. 13	R. 17W
------------	------------	-----------


WELL NO. #3 Dreiling "A" FARM

COMPANY Brooks Pierce Drlg.

CONTRACTOR Braden Drlg.

SE Sugarloaf Pool

Ft. from N. Line  
990  
Ft. from S. Line  
Ft. from E. Line  
990  
Ft. from W. Line

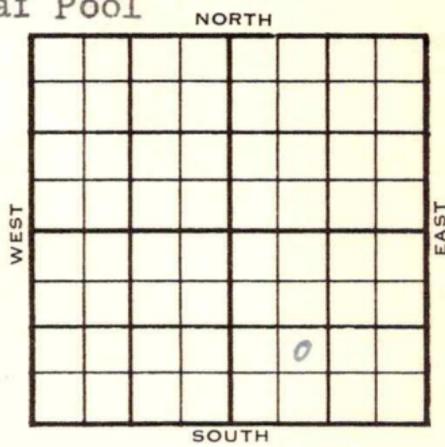

NE SW SE

	ELEVATION	REPORT
--	-----------	--------

1953	1962'	
10/14	Spud 10-7-53 8" @ 160' Anhy 1180' Drlg 3150'	
10/21	Heeb 3192, <sup>U</sup> odge 3212, Lans 3235 DST 3239-68', 1 hr., 6' M DST 3295-3340, 1 hr., 135' HO&GCM 120' gco, 560# Cong 3461, Arb. 3745 DST 3476-85, 1½ hrs., 60' mco, 30' free oil, 720# RTD 3490 5" @ 3476	
10/28	CO	
11/4	DD 3495' S/1 BO 500 A No help	
11/11	NR	
11/18	"	
12/16	Spud 10-7-53 Oil well TD 3495 8" @ 160 Anhy 1180' Heeb 3192 Dodge 3212 Lans. 3235 DST 3239-68 open 1 hr rec 6' mud DST 3295-3340 open 1 hr rec 135' HO & GCM, 120' GCO 560#	

725084

1953  
12/16

(Information continued)

Cong. 3461' Arb. 3475'

DST 3476-85 open  $1\frac{1}{2}$  hr, rec 60' MCO

30' free oil, 720# TD 3490

5" @ 3476 DD 3495 S/1 BO

500 A sd-frac S/18 BOPH

Comp. 209 BOPD

**COMPLETED**



