


Section 28 Township 13 Range 17W

Well No. #2 Dreiling "B"

Company Glenn Nye Drlg.

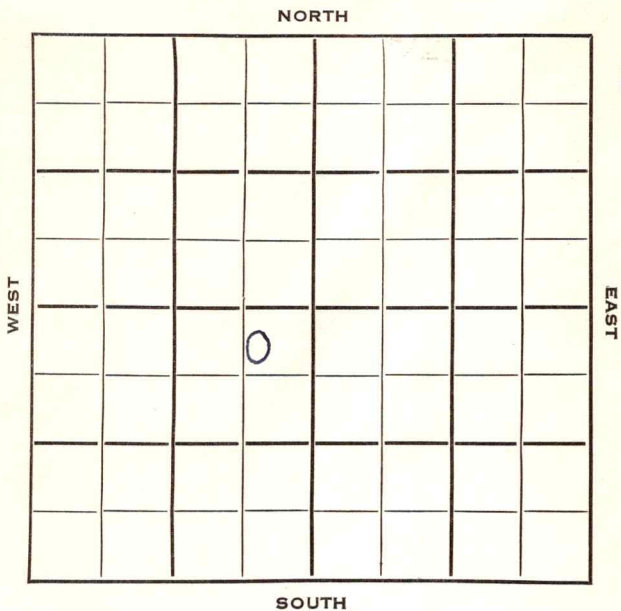

Ellis

KANSAS

SEC.	TWP.	R.
28	13	17 W ✓

WELL NO. # 2 Dreiling "B" FARM

COMPANY

CONTRACTOR Glenn Nye Drlg.

Glenn Nye


E. Sugar Loaf Pool

\_\_\_\_\_ Ft. from N. Line

2200 \_\_\_\_\_ Ft. from S. Line

550 \_\_\_\_\_ Ft. from E. Line

\_\_\_\_\_ Ft. from W. Line

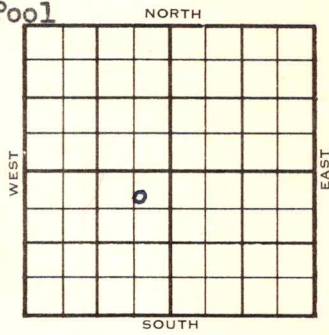

SW ~~NE~~ NE SW

	ELEVATION	REPORT
1953	1986'	

10/7 Spud 10-4-53  
8" @ 104  
Drlg. 3057'

10/14 Heeb 3221, Tor 3241', Lans 3264'  
DST 3303-30', 1 hr., 30' M, O#

10/21 Spud 10-4-53  
D&A  
TD 3579'  
8" @ 104  
Heeb 3221, Tor 3241, Lans 3264  
DST 3303-30, opn 1 hr., rec. 30' mud,  
O#  
Cong 3509  
TD 3579  
D&A

**ABANDONED**

County Ellis State Kansas

Sec. 28 (Blk. 13) (Sur. 17W) Map No.

Operator Glenn Nye Drlg.

Well No. 2 Farm Dreilling "B"

Elev. \_\_\_\_\_ Location SW NE SW



<sup>2200</sup>  
~~990~~ Ft. From <sup>S</sup> N. Line SW  
<sup>550</sup>  
~~920~~ Ft. From E Line Quarter

1st. Report OCT 7 1953

Completion \_\_\_\_\_

Remarks \_\_\_\_\_

Glenn Nye - Contr.

Spudding Date 10-4-53

Drlg. Data E. Sugar Loaf Pool

8" @ 104 drlg. 3057

County Ellis State Kansas

Sec. 28 (Blk.) 13 (Sur.) 17W Map No.

Operator Glenn Nye Drlg.

Well No. 2 Farm Dreiling "B"

Elev. 1986 Location SW NE SW


ABANDONED

X

o

2200 Ft. From S Line SW

550 Ft. From E Line Quarter

Ist. Report

Completion OCT 21 1953

Remarks E. Sugar Loaf Pool

Glenn Nye - Contr.

Spudding Date 10-4-53

Drlg. Data D & A TD 3579

8" @ 104 Heeb. 3221 Tor. 3241

Lans. 3264 DST 3303-30 open 1 hr.

Rec. 30' mud O# Cong. 3509 TD 3579

D & A