

Sec. 28 Twp. 13 R. 17W ✓

Well No. #2 Dreiling Farm

Glenn Nye Company

Glenn Nye Contractor


990 Ft. from N. Line

Ft. from S. Line

330 Ft. from E. Line

Ft. from W. Line

SE NE SE

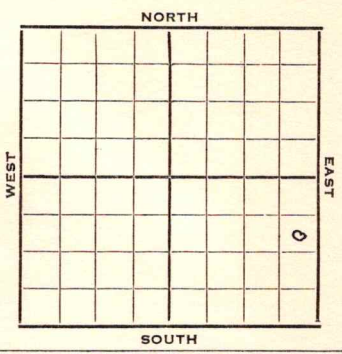

1952 Elev. 1957' REPORT

5/7 MI
 5/14 8" @ 171'
 Anhy 1168'
 Drlg. 3155'
 5/21 Heeb. 3186 Lans. 3228
 DST 3242-3310 3/4 hr.
 130' V HOCM 450# Arb. 3471-75 RTD
 5" @ 3472
 5/28 DD @ 3483'
 6/11 TD 3500 S/12 BOPH POP
 6/18 NR
 6/25 Oil Well TD 3500' 8" @ 171'
 Anhy 1168 Heeb. 3186
 Lans. 3228
 DST 3242-3310 open 3/4 hr. rec. 130'
 vhocm Arb. 3471 5" @ 3472
 TD 3475 DD 4383 DD 3500 S/ 12 boph
 Comp. 122 bopd

COMPLETED

