

Ellis

KANSAS ✓

Sec. 28 Twp. 13 R. 17W

Well No. #2 Drilling "A"
~~#1-B Drilling~~

Brooks Pierce

Company

Braden Drlg.

Contractor


Ft. from N. Line

990 Ft. from S. Line

~~350~~ 330 Ft. from E. Line

Ft. from W. Line

NE SE SE (TWIN WELLS)

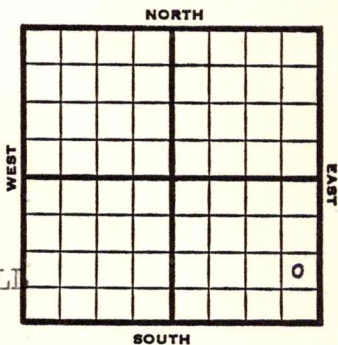

1953

Elev. 1958' REPORT

1/14 Spud 1-8-53
8" @ 154
Anhy 1180
Drlg. 1695'

1/22 Heeb 3185' Lans. 3230'
Drlg 3470'

1/29 Arb. 3476
RTD 3484
5" @ 3481

2/5 NR

2/12 DD 3507' 26 GOPH 1000 A
S/3/4 BOPH 24 hrs. Hyd
tub split S/1 1/2 BOPH

2/19 Testing

2/26 "

3/12 "

3/19 "

3/26 "

4/2 "

4/9 "

4/16 "

4/23 "

4/30 "

5/7 "

OVER

1953

5/21 Testing

725101

5/28 N.R.

6/3 "

6/17 Spud 1-8-53

Oil Well

TD 3511'

8" @ 154'

Anhy 1180, Heeb 3185, Lans 3230, Arb
3476,

TD 3484'

5" @ 3481'

DD 3507' 26 goph 12 hr. 1000 A

S/ 3/4 boph 24 hr. Hydro. S/ 1 $\frac{1}{2}$ boph

3 boph 10 hr. DD 3509' Hydro.

DD 3511'

Comp. 41 bopd.

COMPLETED

Kansas

Map No. _____ Sec. 28 Twp. 13 R. 17W

Well No. 2 Dreiling "A"

Brooks Pierce Company

CORRECTION Contractor

NE SE SE

SECTION PLAT

_____ Ft. from N. Line

990 Ft. from S. Line

350 SB
330 Ft. from E. Line

_____ Ft. from W. Line

			o

Ellis County

Location _____

Rig up _____

Drilling and Remarks: .

Reported
#1-B Dreiling

RECORD

Cased _____ in., _____ ft.

Sand _____

Gas _____

Oil _____

Total Depth _____

PRODUCTION

1st 24 hrs. Nat. _____

1st 24 hrs. after shot _____

Gas _____ Cu. Ft.

Dry Hole _____

Abandoned _____

Date

JAN 21 1952 19

J. G. McGEHEE Scout

Map No. _____ Sec. 28 Twp. 13 R. 17W

Well No. 2 Dreiling "A"

Brooks Pierce Company

CORRECTION Contractor

NE SE SE

SECTION PLAT

			o

_____ Ft. from N. Line

990 Ft. from S. Line

330 Ft. from E. Line

_____ Ft. from W. Line

Ellis County

RECORD

Location _____

Cased _____ in., _____ ft.

Rig up _____

Sand _____

Drilling and Remarks:

Gas _____

Reported

Oil _____

#1-B Dreiling

Total Depth _____

PRODUCTION

1st 24 hrs. Nat. _____

1st 24 hrs. after shot _____

Gas _____ Cu. Ft.

Dry Hole _____

Abandoned _____

Date

1 8 1953

J. G. McGEHEE Scout

