


Section 25 Township 15 Range 18 W

Well No. # 1 Unrein "B"

Company Peel-Hardman

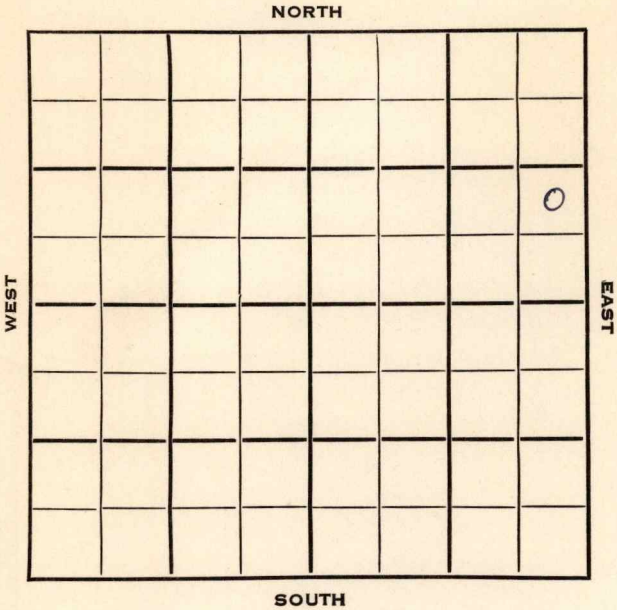

SEC.	TWP.	R.
25	15	18W

WELL NO.

1 Unrein "B"

FARM

COMPANY

Peel-Hardman

CONTRACTOR

Peel

SW Wheatland Pool

Ft. from N. Line


990

Ft. from S. Line

330

Ft. from E. Line

Ft. from W. Line

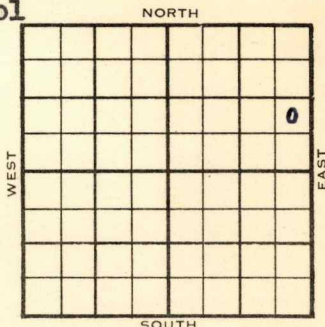

NE SE NE

	ELEVATION	REPORT
1954	1962'	

5/12

Spud 5-7-54

8" @ 1119'

Anhy 1109'

Drlg. 1704'

5/19

RTD 3562 5" @ 3561

6/30

Spud 5-7-54 - Oil Well

TD 3575'

8" @ 1119'

Anhy 1109',

TD 3562'

5" @ 3561'

Heeb 3204', Mans 3254', Arb. 3510'

DD 3575'

B/wtr

PB 3575', B/wtr


EB 3536 48/3516-32, 4500A

B/3 boph 3 hrs.

Comp. 112 bopd 32% wtr.

COMPLETED

J. G. McGEHEE

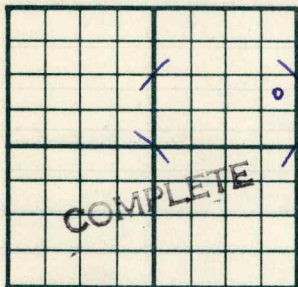County Ellis State KansasSec. 25 (Blk.
Twp.) 15 (Sur.
Rge.) 18W Map No.Operator Peel-HardmanWell No. 1 Farm Unrein "B"Elev. 1962 Location NE SE NE990 Ft. From S Line NE330 Ft. From E Line Quarter1st. ReportCompletion JUN 30 1954Remarks SW Wheatland PoolPeel - Contr.Spudding Date 5-7-54Drlg. Data Oil well TD 35758" @ 1119 Anhy 1109 TD 3 5625" @ 3561 Heeb. 3204 Lans. 3254Arb. 3510 DD 3575 B/ wtr. PB 3575B/ wtr. PB 3536 48/ 3516-32 4500 AB/ 3 boph 3 hr. Comp. 112 bopd 32% wtr.