

Section 36 Township 14 Range 13W

Well No. #2 Weinmeister "B"

Company Keystone Pet.

**NORTH**

WEST

EAST

**SOUTH**

Russell

KANSAS

Sec. 36 Twp. 14 R. 13 W

Well No. # 2 Weinmeister "B" Farm

Keystone Pet.

Company

Contractor

Hall-Gurney Pool

990

Ft. from N. Line


Ft. from S. Line

Ft. from E. Line

330

Ft. from W. Line

SW NW NW

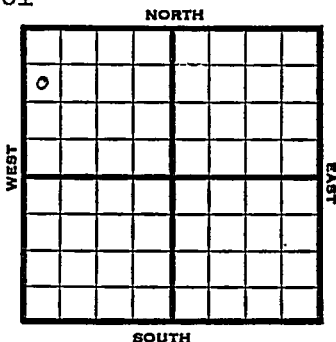

1951

Elev. 1684'

REPORT

9/12

Pits

11/28

Spud 10-25-51

Oil Well

TD 2187

15" @ 31

Anhy 604

10" @ 605

Tarkio 2180

5" @ 2181

TD 2187

S/ 1 1/2 BOPH

Hydrofrac

Comp. 100 BOPD

**COMPLETED**

County Russell State KansasSec. 36 (Blk. 14) (Sur. 13W) (Twp.) 14 (Rge.) 12W Map No.Operator Keystone Pet.Well No. 2 Farm Weinmeister "B"Elev. Location SW NW NW

|   |  |  |  |  |  |  |  |
|---|--|--|--|--|--|--|--|
|   |  |  |  |  |  |  |  |
| 6 |  |  |  |  |  |  |  |
|   |  |  |  |  |  |  |  |
|   |  |  |  |  |  |  |  |
**FIRST REPORT**

990 Ft. From N Line NW330 Ft. From W Line Quarter1st. Report SEP 12 1951

Completion

Remarks

Spudding Date

Drlg. Data Hall-Gurney PoolPits

County Russell State KansasSec. 36 (Blk.  
Twp.) 14 (Sur.  
Rge.) 13W Map No.Operator Keystone Pet.Well No. 2 Farm Weinmeister "B"Elev. 1684 Location SW NW NW

|   |  |  |  |  |  |  |  |
|---|--|--|--|--|--|--|--|
|   |  |  |  |  |  |  |  |
| o |  |  |  |  |  |  |  |
|   |  |  |  |  |  |  |  |
|   |  |  |  |  |  |  |  |
990 Ft. From N Line NW330 Ft. From W Line Quarter

1st. Report

Completion NOV 28 1951Remarks Hall-Gurney PoolSpudding Date 10-25-51Drig. Data Oil well TD 218715" @ 31 Anhy 604 10" @ 605Tarkio 2180 5" @ 2181 TD 2187S/ 1½ boph Hydrofrac Comp. 100 bopd

J. E. TYRA