


Section 35 Township 33 Range 3 E

Well No. # 2 Wright "G"

Company Helmerich & Payne

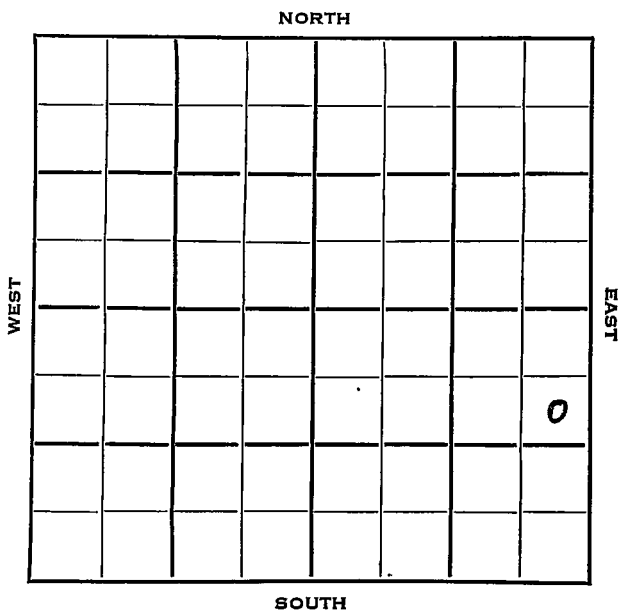

Sec. 35 Twp. 33 R. 3E

Well No. #2 Wright "G" Farm

Helmerich & Payne Company

Contractor


990 Ft. from N. Line

\_\_\_\_\_ Ft. from S. Line

330 Ft. from E. Line

\_\_\_\_\_ Ft. from W. Line

SE NE SE

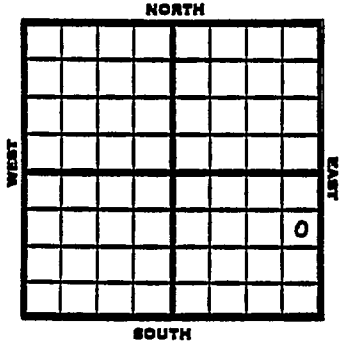

1952 Elev. - REPORT

12/3 Pits  
 12/17 Spud 12-4-52  
 D&A  
 TD 3365  
 8" @ 114  
 Stal 2190, Layton 2612,  
 KC 2795, Oswego 2995, Cherokee  
 3110, Miss 3353  
 TD 3365  
 D&A

**ABANDONED**



