

Ellis

KANSAS  
17W

Section 28- Township 13 Range 17W

Well No. #1 Rome

Company Lewis Drlg.

NORTH

							0

WEST

EAST

SOUTH

1

Sec. 28 Twp. 13 R. 17-W

Well No. #1 Rome Farm

Lewis Drlg. Company

Lewis Drlg. Contractor

Catherine S


330 Ft. from N. Line

\_\_\_\_\_ Ft. from S. Line

330 Ft. from E. Line

\_\_\_\_\_ Ft. from W. Line

NE NE NE

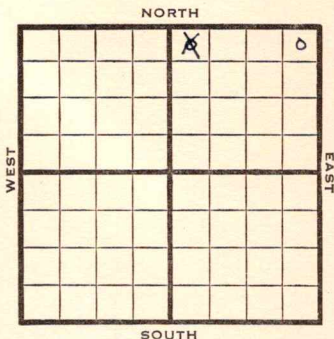

1950

Elev 1964

REPORT

7/19

Spud 7-14-50

8 5/8" @ 119

Anhy 1190

Drlg 2295

8/2

8 5/8" @ 119

Anny 1190

KC 3290

Arb 3648-49 TD

D&A

**ABANDONED**

Map No. \_\_\_\_\_ Sec. 28 Twp. 13 R. 17W


Well No. 1 Rome

Lewis Drlg. \_\_\_\_\_ Company

Lewis Drlg. \_\_\_\_\_ Contractor

NE NE NE

SECTION PLAT

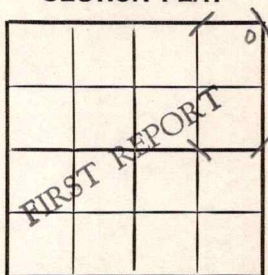

330 Ft. from N. Line

\_\_\_\_\_ Ft. from S. Line

330 Ft. from E. Line

\_\_\_\_\_ Ft. from W. Line

Ellis County

Location \_\_\_\_\_

Rig up \_\_\_\_\_

Drilling and Remarks:

Spud 7-14-50

8 5/8" @ 119

Anky 1190

drlg. 2295

RECORD

Cased \_\_\_\_\_ in., \_\_\_\_\_ ft.

Sand \_\_\_\_\_

Gas \_\_\_\_\_

Oil \_\_\_\_\_

Total Depth \_\_\_\_\_

PRODUCTION

1st 24 hrs. Nat. \_\_\_\_\_

1st 24 hrs. after shot \_\_\_\_\_

Gas \_\_\_\_\_ Cu. Ft.

Dry Hole \_\_\_\_\_

Abandoned \_\_\_\_\_

Date

JUL 19 '950

County Ellis State Kansas

Sec. 28 (Blk. 13) (Sur. 17W) (Twp.) Map No.

Operator Lewis Drlg.

Well No. 1 Farm Rome

Elev. 1964 Location NE NE NE


330 Ft. From N Line NE  
330 Ft. From E Line Quarter

Ist. Report

Completion AUG 2 1950

Remarks

Spudding Date 7-14-50

Drlg. Data South Catherine Pool

8 5/8" @ 119 Anny 1190 KC 3290

Arb. 3648-49 TD

D & A

**ABANDONED**