



Ellis

Map No.            Sec. 26 Twp. 15 R. 18<sup>w</sup>

Well No. X-Madden Est #1 Farm


Bridgeport & Hall Company

330 Ft. from N. Line

\_\_\_\_\_ Ft. from S. Line

\_\_\_\_\_ Ft. from E. Line

990 Ft. from W. Line

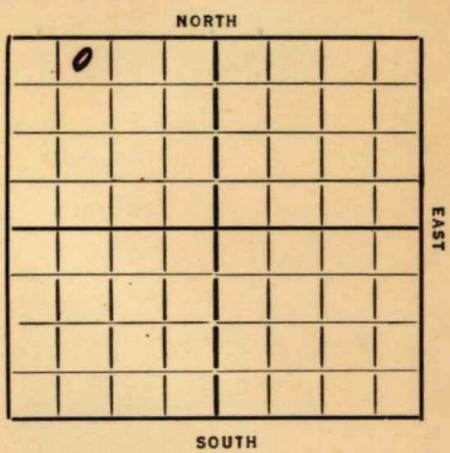

Elev. 1999 L-5

REPORT

O. W. D. D

Date	Description
3/4	Moving In
3/13	--
3/20	BR.
3/27	Rig.
4/2	Spud.
4/10	350' S.D.
4/16	15" @ 384' Drlg. 530'
4/23	Drlg. 858'.
4/30	10" @ 1105'
5/7	Drlg. 1880'.
5/14	Drlg. 2505'.
5/21	2795'. U.R. 8".
5/28	--
6/4	8" @ 2875'. -2910'.
6/11	Topeka 2935'. Drlg. 2980'.
6/18	Pay 3331-40 Filled up 100 feet per hour Acidizing ( Telegram )

OVER

7/1/36-Lansing 3331'.

Pay 3331-40'.

T.D. 3341'.

2,000 gallons of acid.

476 bbls of oil. ( Potential )

COMPLETED ~~COMPLETED~~ COMPLETED

O. W. D. D

9/23/36- Old total depth 3341'  
Rigging up.

10/1-6" @ 3330'. TD 3435'. 1 bailer of  
oil per hour. Clean out.

10/8--

10/15-5" @ 3464'. Drilling 3470'.

10/22-Sil. <sup>3584</sup>~~3589~~' . 5" @ 3588'. TD 3597'.  
Waiting on cement. 600' of oil in  
hole.

10/29-Swabb 12½ bbls of oil per hour for  
12 hours.

11/4- Sil. 3584

T. D. 3595

2000 acid

Pot. 619

COMPLETED

Map No. 74 Sec. 26 Twp. 15 R. 18<sup>n</sup>

Well No. 2-Madden Est.

Bridgeport + Hall Company

Contractor

FIRST REPORTS

SECTION PLAT

330 Ft. from N. Line

..... Ft. from S. Line

..... Ft. from E. Line

990 Ft. from W. Line

0			

Location.....

Rig up.....

Drilling and Remarks:

*Moving in*

RECORD

Cased..... in., ..... ft.

Sand.....

Gas.....

Oil.....

Total Depth.....

PRODUCTION

1st 24 hrs. Nat.....

1st 24 hrs. after shot.....

Gas..... Cu. Ft.

Dry Hole.....

Abandoned.....

Date

3-4-36 192.....

ORVAL MANNSCHRECK  
Scout

Sam - Check the well # on this ticket. Our tracing does not show any other well in Sec. 26-15-18W

Pittman.  
Eng Dept.

~~calling this well #2  
The way they are  
miniberry them~~

Returned	
Cards	
Tracing	
France Map	
Scarborough Map	
Moody Map	
Scarborough Plat Book	
Moody Plat Book	

*[Handwritten signatures and initials over the form]*

Date

Serial

193

Map No. 74 Sec. 26 Twp. 15 R. 18W

Well No. 2 Madden Estate

Bridgeport & Hall Company  
Contractor

SECTION PLAT

6			

330 Ft. from N. Line

\_\_\_\_\_ Ft. from S. Line

\_\_\_\_\_ Ft. from E. Line

990 Ft. from W. Line

COMPLETED

Location \_\_\_\_\_

Rig up \_\_\_\_\_

Drilling and Remarks:

*Leasing 8331  
Pay 3331-40  
2000 acid  
P & 476 88*

RECORD

Cased \_\_\_\_\_ in., \_\_\_\_\_ ft.

Sand \_\_\_\_\_

Gas \_\_\_\_\_

Oil \_\_\_\_\_

Total Depth 3341

PRODUCTION

1st 24 hrs. Nat. \_\_\_\_\_

1st 24 hrs. after shot \_\_\_\_\_

Gas \_\_\_\_\_ Cu. Ft.

Dry Hole \_\_\_\_\_

Abandoned \_\_\_\_\_

Date

JUL 1 1936 19

S. J. LEWIS Scout

KANSAS

Map No. 74 Sec. 26. Twp. 15 R. 18W.

Well No. 2 Maulden Est

Bridgport & Hall Company

Contractor

SECTION PLAT

0			

330 Ft. from N. Line

\_\_\_\_\_ Ft. from S. Line

\_\_\_\_\_ Ft. from E. Line

990 Ft. from W. Line

FIRST REPORT

OW 111

Location \_\_\_\_\_

Rig up \_\_\_\_\_

Drilling and Remarks:

Old T 113341

Rigging up.

RECORD

Cased \_\_\_\_\_ in., \_\_\_\_\_ ft.

Sand \_\_\_\_\_

Gas \_\_\_\_\_

Oil \_\_\_\_\_

Total Depth \_\_\_\_\_

PRODUCTION

1st 24 hrs. Nat. \_\_\_\_\_

1st 24 hrs. after shot \_\_\_\_\_

Gas \_\_\_\_\_ Cu. Ft.

Dry Hole \_\_\_\_\_

Abandoned \_\_\_\_\_

Date

SEP 23 1936

19

S. J. LEWIS

Scout

Map No. 74 Sec. 26 Twp. 15 R. 18W

Well No. 2. Madden Est.

Bridgeport & Hall Company  
Contractor

**SECTION PLAT**

0			

330 Ft. from N. Line

\_\_\_\_\_ Ft. from S. Line

\_\_\_\_\_ Ft. from E. Line

990 Ft. from W. Line

**COMPLETED**

Location \_\_\_\_\_

Rig up \_\_\_\_\_

Drilling and Remarks:

*Sil 3584*  
*2000 acid*  
*P 8619*

**RECORD**

Cased \_\_\_\_\_ in., \_\_\_\_\_ ft.

Sand \_\_\_\_\_

Gas \_\_\_\_\_

Oil \_\_\_\_\_

Total Depth 3595

**PRODUCTION**

1st 24 hrs. Nat. \_\_\_\_\_

1st 24 hrs. after shot \_\_\_\_\_

Gas \_\_\_\_\_ Cu. Ft.

Dry Hole \_\_\_\_\_

Abandoned \_\_\_\_\_

Date

NOV 4 1936 19

*S. J. LEWIS*  
Scout

KANSAS Ellis

Map No. 74 Sec. 26 Twp. 15 R. 18W.

Well No. 1 Madda Estate

Bridgport etal Company

Contractor

OK

SECTION PLAT

0			

380 Ft. from N. Line

\_\_\_\_\_ Ft. from S. Line

\_\_\_\_\_ Ft. from E. Line

990 Ft. from W. Line

CORRECTION

Location \_\_\_\_\_

Rig up \_\_\_\_\_

Drilling and Remarks:

*was Reported  
as No 2.  
have changed  
it to No 1  
correct Feet  
Measurements*

RECORD

Cased \_\_\_\_\_ in., \_\_\_\_\_ ft.

Sand \_\_\_\_\_

Gas \_\_\_\_\_

Oil \_\_\_\_\_

Total Depth \_\_\_\_\_

PRODUCTION

1st 24 hrs. Nat. \_\_\_\_\_

1st 24 hrs. after shot \_\_\_\_\_

Gas \_\_\_\_\_ Cu. Ft.

Dry Hole \_\_\_\_\_

Abandoned \_\_\_\_\_

Date

MAR 25 1937

19

S. J. LEWIS

Scout