


Section 28 Township 13 **KANSAS** Range 17 W

Well No. # 2 Rome

Company A. & A. Oil Co.

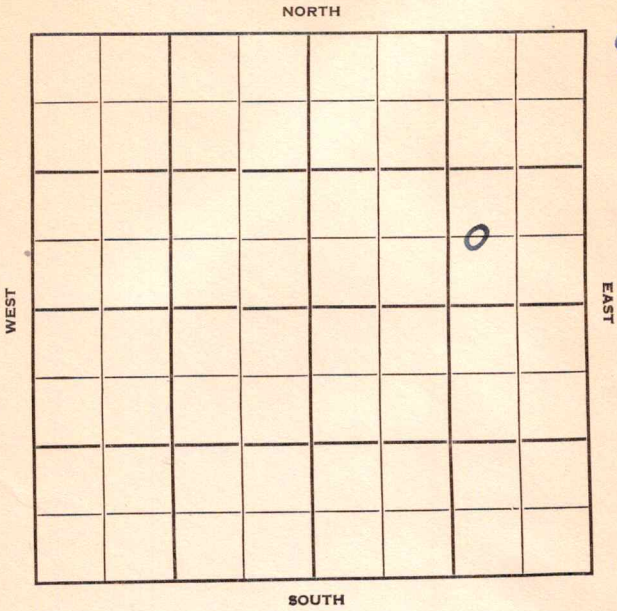

Sec. 28 Twp. 13 R. 17W

Well No. #2 Rome Farm

A & A Oil Co. Company

SE Sugarloaf Pool Contractor


Ft. from N. Line

660 Ft. from S. Line

990 Ft. from E. Line

Ft. from W. Line

C W L SE NE

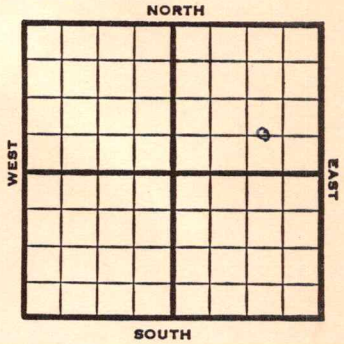

1952 Elev. 1963' REPORT

11/18 MIR

11/27 Drlg. 2300'

12/4 NR

12/10 Spud 11-19-52
 D & A TD 3550' 8" @ 280 Anhy 1183'
 Heeb 3219' Lans. 3264' Cong. 3484'
 Arb. 3508'
 TD 3550' D & A

ABANDONED

County Ellis State Kansas

Sec. 28 (Blk. Twp.) 13 (Sur. Rge.) 17W Map No.

Operator A & A Oil Co.

Well No. 2 Farm Rome

Elev. 1963 Location C W L SE NE



660 Ft. From S Line NE

990 Ft. From E Line Quarter

1st. Report

Completion DEC 1 0 1952

Remarks SE Sugar Loaf Pool

Spudding Date 11-19-52

Drlg. Data D & A TD 3550

8" @ 280 Anhy 1183 Heeb. 3219

Lans. 3264 Cong. 3484 Arb. 3508

TD 3550

D & A

J. G. McGEHEE