


Section 26 Township 15 Range 18-W

Well Number 2 Madden Estate

Company Bridgeport et al

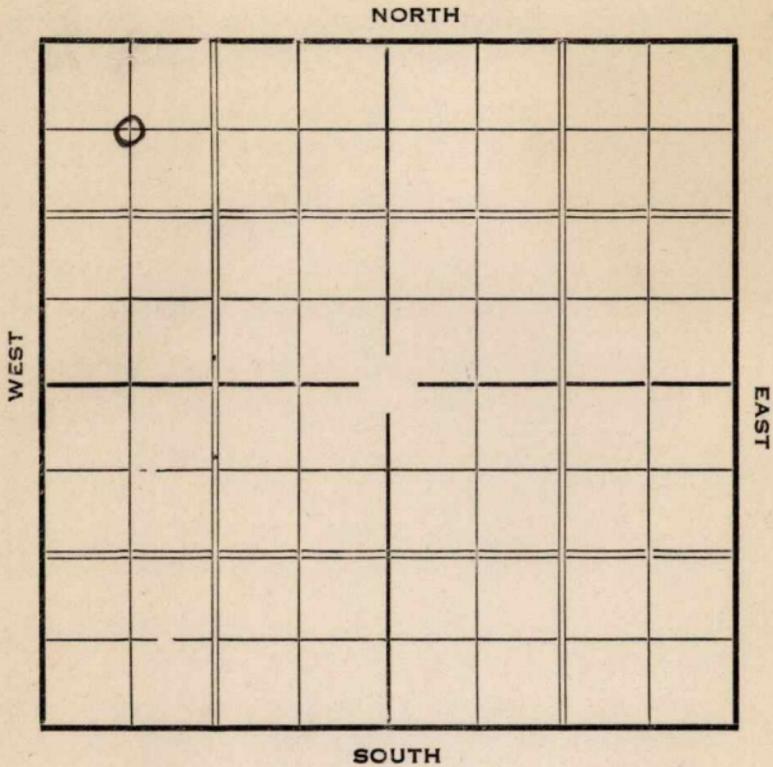

Sec. 26 Twp. 15 R. 18-W

Well No. #2 Madden Estate Farm

Bridgeport et al Company

755

~~600~~ Ft. from N. Line


Ft. from S. Line

Ft. from E. Line

565

~~600~~ Ft. from W. Line

1986

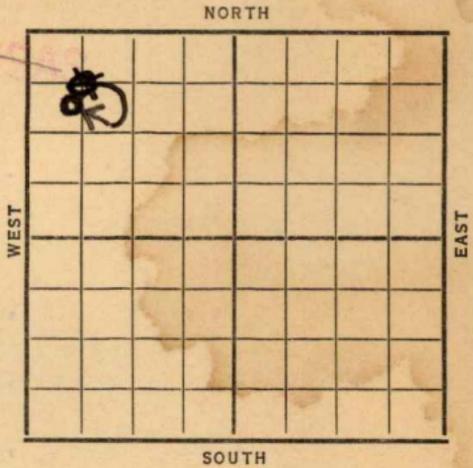

Date

REPORT

1937

3/24 Rigging up

4/2 335' fishing.

4/8 15" @ 400'. Drlg. 840'.

4/16 **Anhydrate 1125'**, 10" @ 1132',

Drlg. 1150'

4/23 Drlg. 1960'.

4/30 10" @ 2110'. Drlg. 2515'.

5/7 8" @ 2745'. Drlg. 2995'.

5/14 **Oswald 3280'**, 6" @ 3305'.

Drlg. 3308'.

5/21 **Sil. 3553'**, 5" Liner 3555'.

T.D. 3563'. 2000' oil in

18 hrs.

**OVER**

1937

5/26

6" @ 3305'.

5" liner 3555'.

Sil. 3553'.

T.D. 3565'.

P.B. 3563'.

2000 acid.

Potential 454 bbls.

**COMPLETED**

**KANSAS** Ellis

Map No. \_\_\_\_\_ Sec. 26 Twp. 15 R. 18W.

Well No. 2. Madden Estate

Bridgeport & Co Company

Contractor

**SECTION PLAT**

0			

660 Ft. from N. Line

\_\_\_\_\_ Ft. from S. Line

\_\_\_\_\_ Ft. from E. Line

660 Ft. from W. Line

**FIRST REPORT**

Location \_\_\_\_\_

Rig up \_\_\_\_\_

Drilling and Remarks:

*Rigging up.*

**RECORD**

Cased \_\_\_\_\_ in., \_\_\_\_\_ ft.

Sand \_\_\_\_\_

Gas \_\_\_\_\_

Oil \_\_\_\_\_

Total Depth \_\_\_\_\_

**PRODUCTION**

1st 24 hrs. Nat. \_\_\_\_\_

1st 24 hrs. after shot \_\_\_\_\_

Gas \_\_\_\_\_ Cu. Ft.

Dry Hole \_\_\_\_\_

Abandoned \_\_\_\_\_

Date

MAR 24 1937

19

S. J. LEWIS Scout

Ellis KANSAS

Map No. 74 Sec. 26 Twp. 15 R. 18 W

Well No. 2 Madden Est

Bridgeport Company

Contractor

COMPLETED

SECTION PLAT

755 Ft. from N. Line

\_\_\_\_\_ Ft. from S. Line

\_\_\_\_\_ Ft. from E. Line

565 Ft. from W. Line

(See Correction Ticket)

0			

Location \_\_\_\_\_

Rig up \_\_\_\_\_

Drilling and Remarks:

P.B. 3563

2000 Acid

Pot - 454

6-3305

RECORD

Cased 5" Limer in., 3533ft.

Sand 511 3553

Gas \_\_\_\_\_

Oil \_\_\_\_\_

Total Depth 3565

PRODUCTION

1st 24 hrs. Nat. \_\_\_\_\_

1st 24 hrs. after shot \_\_\_\_\_

Gas \_\_\_\_\_ Cu. Ft.

Dry Hole \_\_\_\_\_

Abandoned \_\_\_\_\_

Date

MAY 26 1937

19

H. D. Hatfield

Scout

Ellis KANSAS

Map No. \_\_\_\_\_ Sec. 26 Twp. 15 R. 18<sup>w</sup>

Well No. 2-Madden Est

Bridgeport Company

Contractor

CORRECTION

SECTION PLAT

755 Ft. from N. Line

\_\_\_\_\_ Ft. from S. Line

\_\_\_\_\_ Ft. from E. Line

565 Ft. from W. Line

0			

Location \_\_\_\_\_

RECORD

Cased \_\_\_\_\_ in., \_\_\_\_\_ ft.

Rig up \_\_\_\_\_

Sand \_\_\_\_\_

Drilling and Remarks:

Gas \_\_\_\_\_

1st reported

Oil \_\_\_\_\_

as 660 From North

Total Depth \_\_\_\_\_

660 ✓ west

PRODUCTION

1st 24 hrs. Nat. \_\_\_\_\_

1st 24 hrs. after shot \_\_\_\_\_

Gas \_\_\_\_\_ Cu. Ft.

Dry Hole \_\_\_\_\_

Abandoned \_\_\_\_\_

Date

MAY 26 1937



19

H. D. Hatfield

Scout

Sam - We show a #1 completed well in NE NW NW 26-15-18W.

Pittman

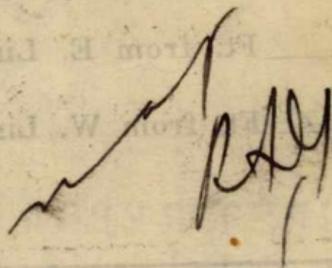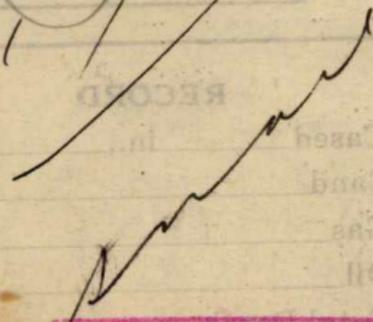

- Returned \_\_\_\_\_
- Cards \_\_\_\_\_
- Tracing \_\_\_\_\_
- France Map \_\_\_\_\_
- Scarborough Map \_\_\_\_\_
- Moody Map \_\_\_\_\_
- Scarborough Plat Book \_\_\_\_\_
- Moody Plat Book \_\_\_\_\_

*Paul*

*[Signature]*