
FORM 51

Ellis KANSAS

Section 28 Township 13 Range 17 W

Well No. # 4 Sophia Dreiling

Company L. J. Dreiling

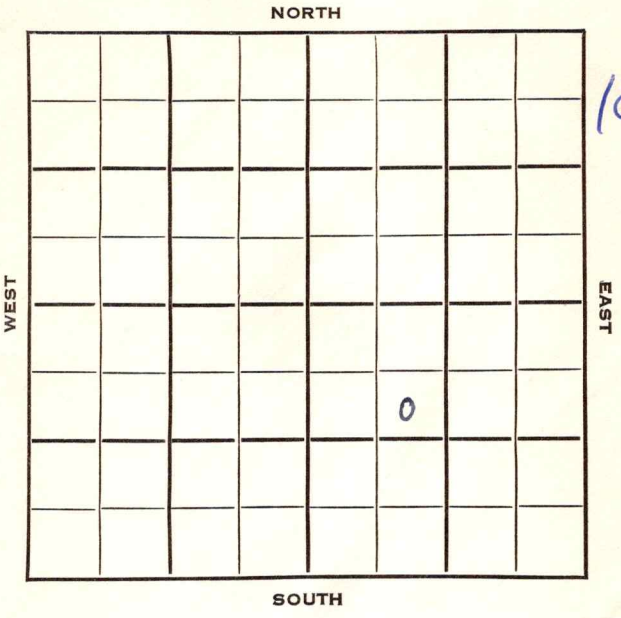

FORM 252-B

Ellis

KANSAS

Sec. 28 Twp. 13 R. 17W

Well No. #4 Sophia Dreiling Farm

L.J. Dreiling Company

Glenn Nye Contractor

SE Sugarloaf Pool


990 Ft. from N. Line

Ft. from S. Line

Ft. from E. Line

990 Ft. from W. Line

SE NW SE

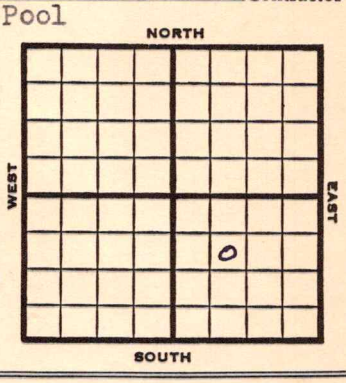

1953	Elev. 1963' REPORT
6/10	Spud 6-6-53 8" @ 120' Drlg 1103'
6/24	No report
7/1	RTD 3474 5" @ 3470 DD 3476 TD FU 700' oil 12 hrs., 1000A 700' oil 12 hrs., S/2 BOPH
7/8	POP
7/22	"
7/29	Spud 6-6-53 Oil well TD 3476 8" @ 120 TD 3474 5" @ 3470 DD 3476 FU 700' oil 12 hr. 1000 A FU 700' oil 12 hr. S/2 BOPH Lans. 3224 Arb. 3466 Comp. 85 BOPD COMPLETED

FORM 275 FOR SALE BY KANSAS BLUE PRINT CO.

County Ellis State Kansas

Sec. 28 (Blk. Twp.) 13 (Sur. Rge.) 17W Map No.

Operator L. J. Dreiling

Well No. 4 Farm Sophia Dreiling

Elev. Location SE NW SE



990 Ft. From N Line SE

990 Ft. From W Line Quarter

1st. Report JUN 10 1953

Completion

Remarks Glenn Nye - Contr.

Spudding Date 6-6-53

Drlg. Data SE Sugarloaf Pool

8" @ 120 drlg. 1103

J. G. McGEHEE

FORM 275 FOR SALE BY KANSAS BLUE PRINT CO.

County Ellis State Kansas

Sec. 28 (Blk. Twp.) 13 (Sur. Rge.) 17W Map No.

Operator L. J. Dreiling

Well No. 4 Farm Sophia Dreiling

Elev. 1963 Location SE NW SE



990 Ft. From N Line SE

990 Ft. From W Line Quarter

1st. Report

Completion JUL 2 9 1953

Remarks SE Sugarloaf Pool
Glenn Nye - Contr.

Spudding Date 6-6-53

Drlg. Data Oil well TD 3476

8" @ 120 TD 3474 5" @ 3470 DD 3476

FU 700' oil 12 hr. 1000 A FU 700' oil

12 hr. S/ 2 both Lans. 3224 Arb. 3466

Comp. 85 bopd

J. G. McGEHEE