


Section 28 Township 13 Range 17W

Well No. 1 Sophia Dreiling "E"

Company L. J. Drieling

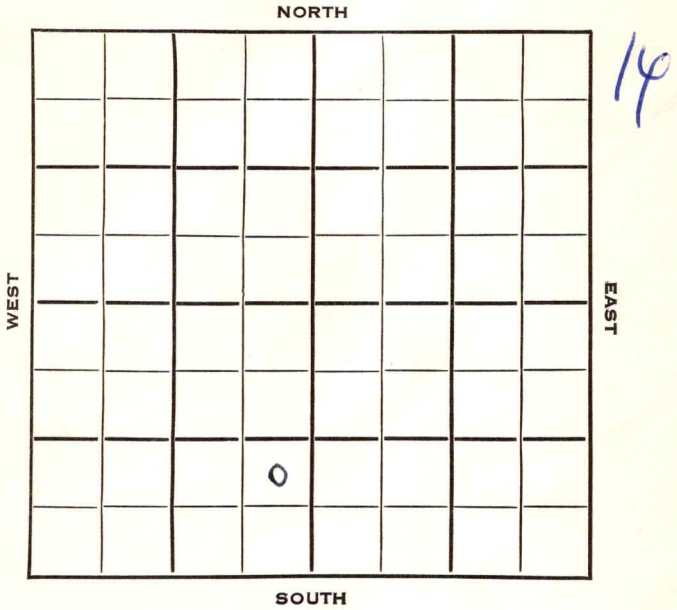

Ellis

KANSAS

SEC.	TWP.	R.
28	13	17W

WELL NO.

COMPANY #1 Sophia Dreiling "E" FARM

CONTRACTOR L. J. Dreiling

Nye


SE Sugar Loaf Pool NORTH

Ft. from N. Line

990 Ft. from S. Line

330 Ft. from E. Line

Ft. from W. Line

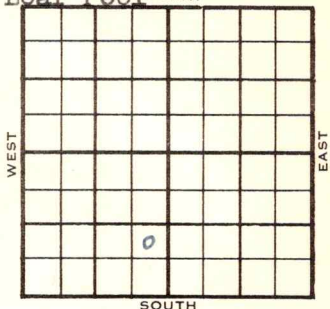

NE SE SW

1954	ELEVATION	REPORT
------	-----------	--------

2016'

1/20 Spud 1-12-54
 8" @ 125'
 Anhy 1230'
 Drlg 3116'

1/27 Spud 1-12-54 D & A TD 3580
 8" @ 125' Anhy 1230 Heeb 3264
 Dodge 3285 Lans 3310 Cong 3561
 TD 3580' D & A

ABANDONED

