

KANSAS

Ellis

Section 26 Township 15 Range 18WWell No. 2 Madden "D"Company Jones & Shelborne

Madden

NORTH

WEST	0							

EAST

SOUTH

KANSAS

Ellis

Sec. 26 Twp. 15 R. 18W ✓

Well No. #2 Madden "D" Farm

Jones & Shelborne

Company

Madden (Jones & Shelborne, Cont'd) ^{NORTH}

Pool
330'

Ft. from N. Line


Ft. from S. Line

Ft. from E. Line

330'

Ft. from W. Line

NW/C

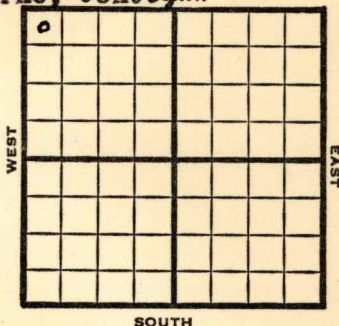

1949

Elev 1986' REPORT

5/18 Location
5/25 8"@ 1135'
6/1 Drlg 3490'
6/7 "
6/15 **Lansing 3258'**
Arb. 3561'
TD 3565
5"@ 3562
1250' oil 12 hrs.
6/21 "
6/28 "
7/6 TD 3565'
Arb. 3561'
5"@ 3562'
Pump 75 Oil Pot
27° Gr.
Comp

COMPLETED

Map No. _____ Sec. 26 Twp. 15 R. 18W

Well No. 2 Madden "D"

Jones & Shelborne Company

Jones & Shelborne Contractor

NW/C


FIRST REPORT
SECTION PLAT

330 Ft. from N. Line

_____ Ft. from S. Line

_____ Ft. from E. Line

330 Ft. from W. Line

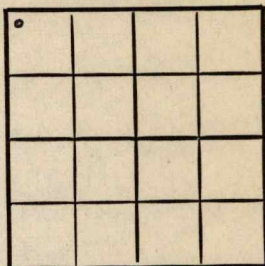

Ellis County

Location X

Rig up _____

Drilling and Remarks:

RECORD

Cased _____ in., _____ ft.

Sand _____

Gas _____

Oil _____

Total Depth _____

PRODUCTION

1st 24 hrs. Nat. _____

1st 24 hrs. after shot _____

Gas _____ Cu. Ft.

Dry Hole _____

Abandoned _____

Date

MAY 18 1949

19

S. J. LEWIS


Scout

Kansas

Map No. K 74 Sec. 26 Twp. 15 R. 18WWell No. 2 Madden "D"Jones & Shelborne Company**COMPLETE**

Contractor

NW/C

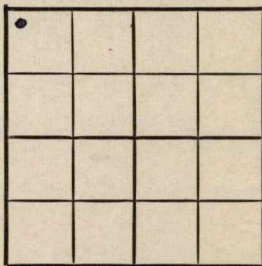E 11/86**SECTION PLAT**330 Ft. from N. Line Ft. from S. Line Ft. from E. Line330 Ft. from W. LineEllis CountyLocation Rig up

Drilling and Remarks:

Ar 735615" @ 3562Puny Soil Out.27-2-86**RECORD**Cased in., ft.Sand Gas Oil Total Depth 3565**PRODUCTION**1st 24 hrs. Nat. 1st 24 hrs. after shot Gas Cu. Ft.Dry Hole Abandoned

Date

JUL 6 1949 19S. J. LEWIS

Scout