


Section 26 Township 15 Range 18W

Well No. #1 Madden "D"

Company Jones & Shelborne

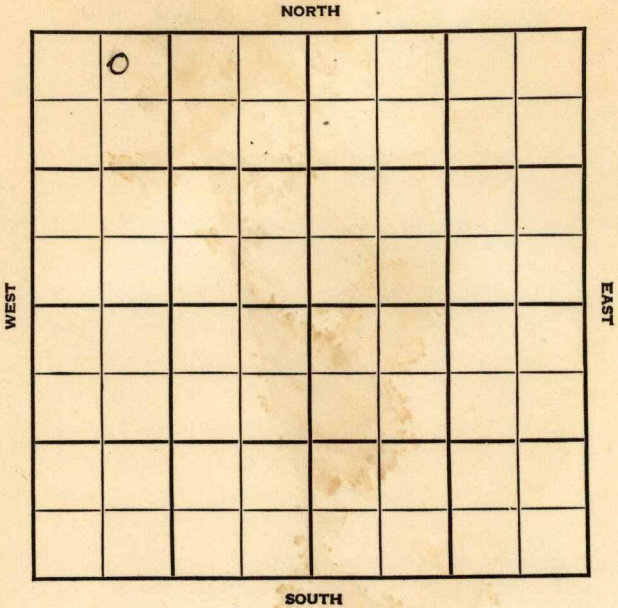



Sec. 26 Twp. 15 R. 18W

Well No. #1 Madden "D" Farm

Jones & Shelborne Company


Pleasant

330 Ft. from N. Line

_____ Ft. from S. Line

_____ Ft. from E. Line

965 Ft. from W. Line

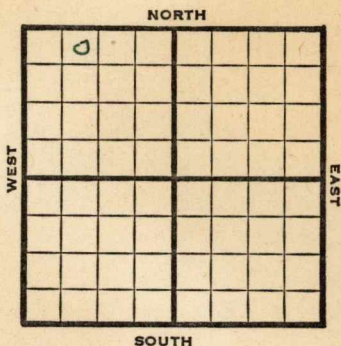

NE NW NW

1947

Elev. 1999' REPORT

12/30

Location

1948

1/7

"

1/14

RUR

1/21

8" @ 802'

WOC

1/26

Drlg 2600'

2/4

Lansing 3275'?

TD 3330'

5" @ 3328'

RUST

2/11

TD 3333'

Swb. 9 bbls. oil PH 8 hrs.

2/18

"

2/25

"

3/3

"

3/10

Lans. 3275'

5" @ 3328'

Pump 75 Pot.

Gr. 26°

TD 3333'

COMPLETED

Map No. _____ Sec. 26 Twp. 15 R. 18W

Well No. 1 Madden "D"

Jones & Shelborne Company

FIRST REPORT

Contractor

NE NW NW

SECTION PLAT

330 Ft. from N. Line

_____ Ft. from S. Line

_____ Ft. from E. Line

965 Ft. from W. Line

<u>D</u>			

Ellis County

Location x

Rig up _____

Drilling and Remarks:

RECORD

Cased _____ in., _____ ft.

Sand _____

Gas _____

Oil _____

Total Depth _____

PRODUCTION

1st 24 hrs. Nat. _____

1st 24 hrs. after shot _____

Gas _____ Cu. Ft.

Dry Hole _____

Abandoned _____

Date

DEC 30 1947

Map No. 74 Sec. 26 Twp. 15 R. 18W

Well No. 1 Madden "D"

Jones & Shelborne Company

COMPLETE Contractor

NE NW NW

2/1/99
SECTION PLAT

330 Ft. from N. Line

_____ Ft. from S. Line

_____ Ft. from E. Line

965 Ft. from W. Line

Ellis County

Location _____

Rig up _____

Drilling and Remarks:

*Lane 8275
5' 03328.*

Pump 75 1/2"

26' 1/2"

RECORD

Cased _____ in., _____ ft.

Sand _____

Gas _____

Oil _____

Total Depth 3333

PRODUCTION

1st 24 hrs. Nat. _____

1st 24 hrs. after shot _____

Gas _____ Cu. Ft.

Dry Hole _____

Abandoned _____

Date

MAR 10 1948

S. J. LEWIS Scout