


Section 1 Township 33 Range 1E

Well No. #1 Fulghum

Company Harold O'Quinn

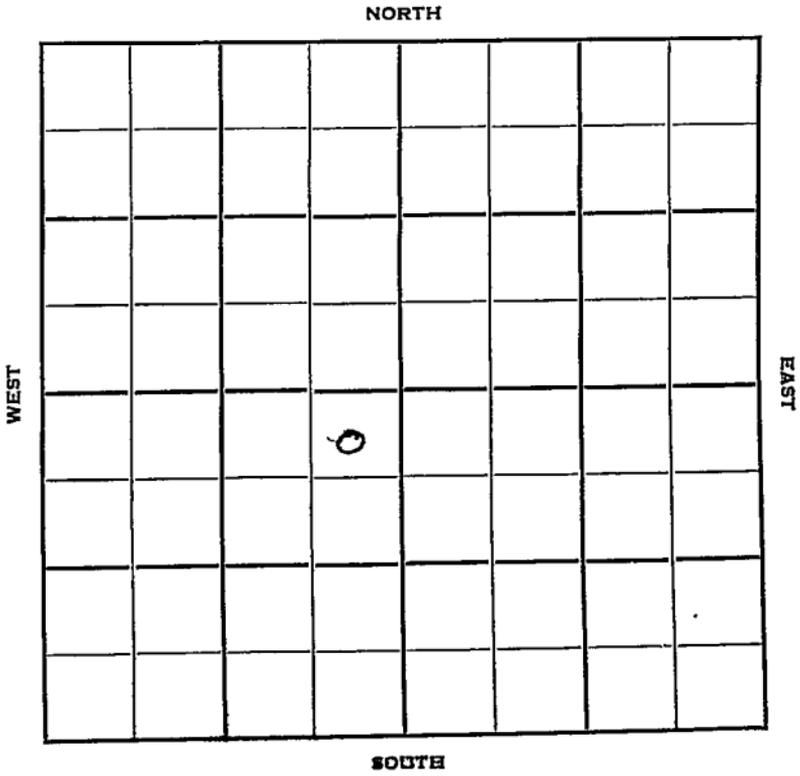

Sec. 1 Twp. 33 R. 4E

Well No. #1 Fulghum Farm \_\_\_\_\_  
 Harold O'Quinn Company \_\_\_\_\_  
 Contractor \_\_\_\_\_


330 Ft. from N. Line

\_\_\_\_\_ Ft. from S. Line

330 Ft. from E. Line

\_\_\_\_\_ Ft. from W. Line

NE NE SW

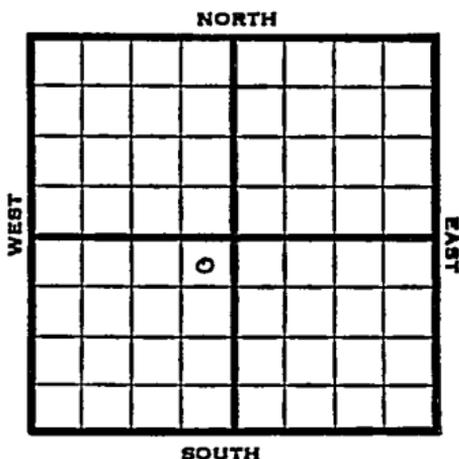

1952

Elev. 1221' REPORT

11/12  
 1953  
 7/15

MIM

Spud 11-18-52

Oil Well .

TD 3020'

10" @ 70'

Hoover 1744, Lans 1933, Stal. 1965,  
 Layton 2381, KC 2537, Peru sd. 2676,  
 Oswego 2754, Bart 2968,

TD 3020'

5" @ 3017'

30 / 2990-3000      30 / 3005-15 P / 12  
 bo Hydro.

28 / 2968-84      30 / 2972-82 P / 4 bopd

PB 1770

21 / 1742-46      24 / 1758-62

Comp. 30 bopd.

**COMPLETED**

County **Cowley** State **Kansas**

Sec. **1** (Blk.) **33** (Sur.) **4E** Map No.

Operator **Harold O<sup>r</sup>Quinn**

Well No. **1** Farm **Fulghum**

Elev. Location **NE NE SW**


FIRST REPORT

**330** Ft. From **N** Line **SW**

**350** Ft. From **E** Line Quarter

Ist. Report **NOV 12 1952**

Completion

Remarks

Spudding Date

Drilg. Data

**M I M**

