
FORM 51 25M 8-50 WESTERN Ellis KANSAS

Section 29 Township 13 Range 17W

Well No. #1 Weber

Company Wick Pet. et al

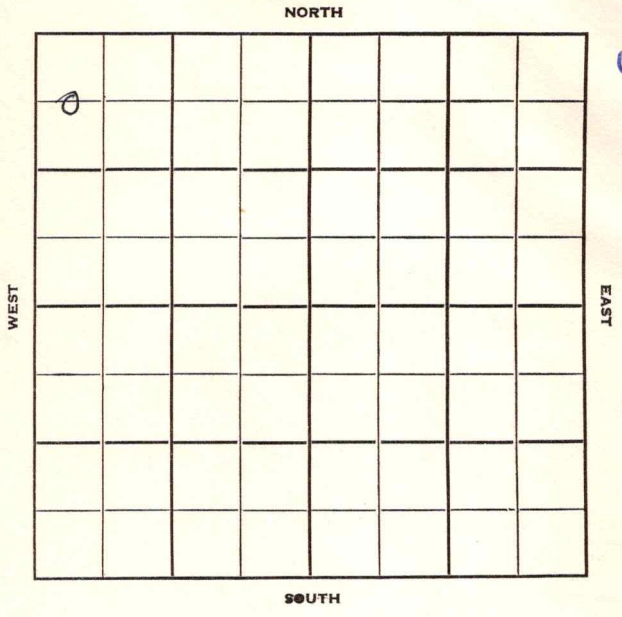


4

FORM 252-B
10M 11-50 PETROL

Ellis KANSAS

Sec. 29 Twp. 13 R. 17W

Well No. #1 Weber Farm

Wick Pet. et al Company

Overland - Contr. Contractor

Wildcat


660' Ft. from N. Line

Ft. from S. Line

Ft. from E. Line

330' Ft. from W. Line

C W L NW NW

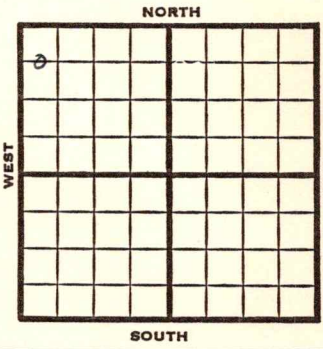


| 1951 | Elev. 2066' REPORT |
|---|---|
| 2/7 | Spud 2-5-51<br>8" @ 151<br>WOC |
| 3/28 | Spud 2-5-51<br>D & A TD 3681'<br>8" @ 151 Heeb. 3333', Lans 3375',<br>DST 3395-3425 open 45 min. Rec. 30'<br>SOCM<br>DST 3445-68 open 45 min. Rec. 30' SW<br>DST 3522-40 open 1 hr. Rec. 65' OCM<br>& free oil Cong. 3609', Arb. 3653-<br>81 TD 5" @ 3599' 36/3533-44,<br>500 A S/½ boph 3000 A<br>S/ 2 boph Dec. to ½ boph ½ bwph<br>PB 3500' 24/3401-10 1000 A<br>water D & A<br>ABANDONED |

3375' 2066 / 1309

3609 2066 / 1543

3653 2066 / 1587

FORM 275 FOR SALE BY KANSAS BLUE PRINT CO.

County Ellis State Kansas

Sec. 29 (Blk. Twp.) 13 (Sur. Rge.) 17W Map No.

Operator Wick Pet. etal.

Well No. 1 Farm Weber

Elev. Location C W L NW NW




660 Ft. From N Line NW

330 Ft. From W Line Quarter

1st. Report FEB 7 1951

Completion

Remarks Overland - Contr.

Spudding Date 2-5-51

Drlg. Data Wildcat

8" @ 151 WOC

J. E. TYRA

FORM 275 FOR SALE BY KANSAS BLUE PRINT CO.

County Ellis State Kansas

Sec. 29 (Blk. Twp.) 13 (Sur. Rge.) 17W Map No.

Operator Wick Pet. etal.

Well No. 1 Farm Weber

Elev. 2066 Location C W L NW NW




660 Ft. From N Line NW

330 Ft. From W Line Quarter

1st. Report

Completion MAR 2 8 1951

Remarks Wildcat

Overland - Contr.

Spudding Date 2-5-51

Drlg. Data D & A TD 3681

8" @ 151 Heeb. 3333 Lans. 3375

DST 3395-3425 open 45 min. Rec. 30' socm

DST 3445-68 open 45 min. Rec. 30' sw

DST 3522-40 open 1 hr. Rec. 65' ocm

&free oil Cong. 3609 Arb. 3653-81 TD

5" @ 3599 36/ 3533-44 500 A S/ ½ boph

3000 A S/ 2 boph Dec. to ½ boph ½ bwph

PB 3500 24/ 3401-10 1000 A water

D & A

J. E. TYRA