


Ellis

Section 27 Township 15 Range 18-W

Well No. 1 Ruder

Company Amerada

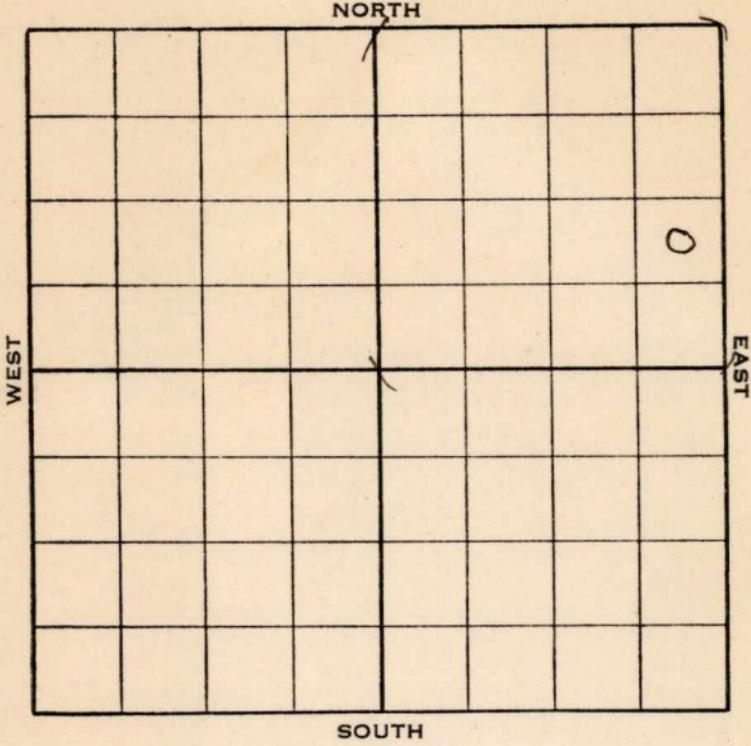

Sec. 27 Twp. 15 R. 18-W

Well No. #1 Ruder Farm


Amerada Company

 Ft. from N. Line

990 Ft. from S. Line

330 Ft. from E. Line

 Ft. from W. Line

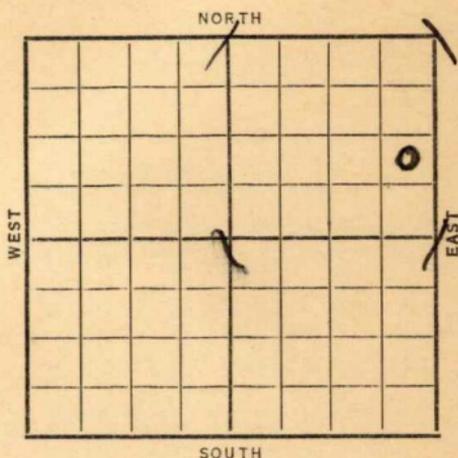

Elev. 2002 L-S

Date	REPORT
1938	
2/16	R.R.
2/26	S. H.
3/4	15" @ 152'. Drlg. 852'.
3/11	Anhy 1145' . T.D. 1172' SD.
3/18	8" @ 1162'. Drlg. 1550'.
3/25	T.D. 1980'. P.B. 1200'.
	to straighten hole.
4/1	Drlg. 1778'.
4/8	Fort Riley 2110' .
	Drlg. 2720'.
4/15	K. C. 3268' . Drlg. 3324'.
4/22	S.O. 3343-55 & 3365-70'.
	Cong. 3540' . Arb. 3578' .
	T.D. 3580'. 7" @ 3578'.
	No shows. RUST.
4/29	S.O. 3580-88' T.D. Will acidize.
5/6	T.D. 3633'. 500' wtr. S.D.O.
	OVER

1938

5/10

7" @ 3578'.

K. C. 3268'.

Arb. 3578'.

T.D. 3633'.

P.B. 3410'.

Perf. 70 shots.

500' water in 10 hrs.

ABANDONED

Ellis **KANSAS**

Map No. 74 Sec. 27 Twp. 15 R. 18W

Well No. 1 Ruder

Amerada Company

Contractor

FIRST REPORT

NE SE NE


_____ Ft. from N. Line

990 Ft. from S. Line

330 Ft. from E. Line

_____ Ft. from W. Line

SECTION PLAT

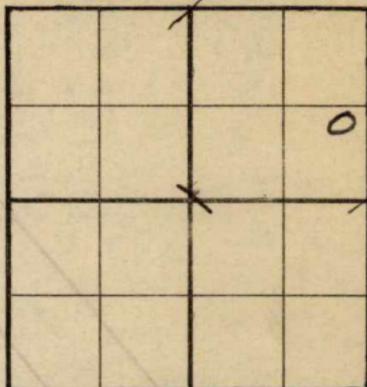

Location _____

Rig up _____

Drilling and Remarks:

RR

RECORD

Cased _____ in., _____ ft.

Sand _____

Gas _____

Oil _____

Total Depth _____

PRODUCTION

1st 24 hrs. Nat. _____

1st 24 hrs. after shot _____

Gas _____ Cu. Ft.

Dry Hole _____

Abandoned _____

Date

FEB 16 1938 19

H. D. Hatfield Scout

Ellis

KANSAS

Map No. 74 Sec. 27 Twp. 15 R. 18W

Well No. 1 Ruder

Amerada

Company

Contractor

ABANDONED

NE SE NE

_____ Ft. from N. Line

990 Ft. from S. Line

330 Ft. from E. Line

_____ Ft. from W. Line

SECTION PLAT

			0

Location _____

Rig up _____

Drilling and Remarks:

P.B. 3410
Perf 70 shots
500' wtr - 10 hrs
DVA

RECORD

Cased 7 in., 3578 ft.

Sand KC 3268

Gas Arb 3578

Oil _____

Total Depth 3633

PRODUCTION

1st 24 hrs. Nat. _____

1st 24 hrs. after shot _____

Gas _____ Cu. Ft.

Dry Hole _____

Abandoned _____

Date

MAY 10 1938

19

H. D. Hatfield

Scout