

O. W. P. B.

FORM 51 25M 3-49 PETROL


Ellis

KANSAS

Section 32 Township 13 Range 17 W

Well No. # 1 Dinkel

Company Ben BRACK  
~~Brook Oil~~

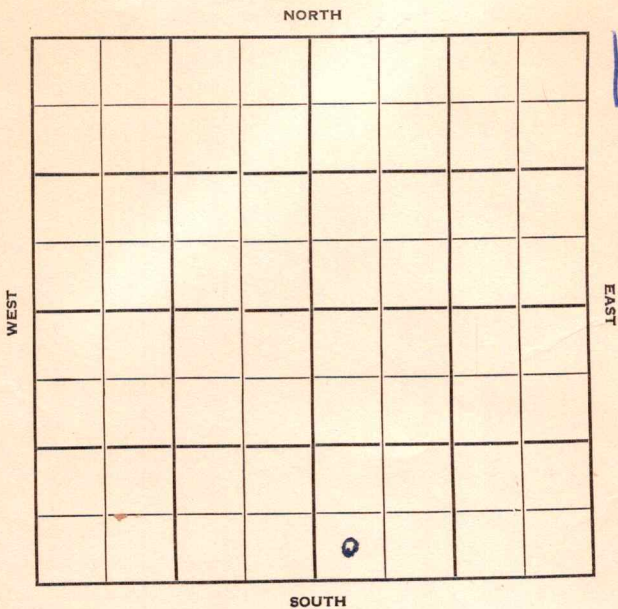

Sec. 32 Twp. 13 R. 17W

Well No. #1 Dinkel Farm

Ben Brack  
Brock Oil

Company

Contractor

Ft. from N. Line

330'


Ft. from S. Line

Ft. from E. Line

330'

Ft. from W. Line

SW SW SE

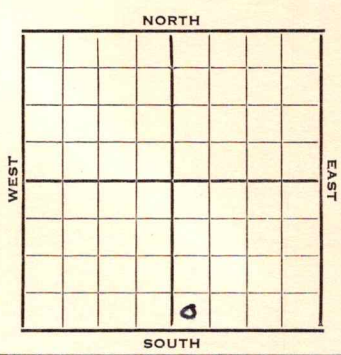

1952 **Elev. 2032'** REPORT

9/17	Spud 9-11-52 8" @ 197 Drlg. 2345
9/24	<b>Lans. 3304'</b> DST 3323'-40', 1 hr, 90' MCO, 360' clean oil 980# DST 3393-5419', 1/2 hr, 8' M 35# <b>Arb. 3550'</b> RTD 3552' 5" @ 3551'
10/1	DD 3554 TD 1/2 BOPH
10/8	"
10/15	1000A S/1 1/2 BOPH to Drlg. Deeper
10/22	1000A P/47 BOPD
10/29	NR
11/5	Spud 9-11-52 Oil Well TD 3554' 8" @ 197 <b>Lans. 3304'</b> DST 3323-40 open 1 hr. rec. 90' mco 360' clean oil 980# DST 3393-3419 open 1/2 hr. rec. 8' mud 35# <b>Arb. 3550</b> 5" @ 3551 TD 3552' DD 3554 1/2 boph 1000 A S/ 1 1/2 boph 1000 A P. 47 bopd Comp. 24 bopd

3304  
2032  
1262

3550  
2032  
1518

**COMPLETED OVER**

725190

1953  
3/25

**O. W. P. B.**

**Lans 3304' Arb. 3550'**  
 OTD 3558' 5" @ 3553 PB 3370  
 24/3331-39 S/1-3/4 BOPH 1000 A  
 Shut in 1 hr. FU 2600' oil  
 S/70 BO 1st hr. S/48 BO 2nd hr.  
 S/24 BO 3rd hr. S/23 BO 4th hr.  
 P/229 BOPD

4/2 NR

4/9 "

4/16 "

4/23 "

4/30 "

5/7 NR

5/21 NR

5/28 "

6/3 "

6/10 Oil Well

TD 3558'

**Lans 3304, Arb 3550,**

OTD 3558'

5" @ 3553'

PB 3370 24/ 3331-39 S/ 1 3/4 boph  
1000 A Shut in 1 hr.

FU 2600' oil S/ 70 bo 1st hr.

S/ 48 bo 2nd hr. S/ 24 bo 3rd hr.

S/ 23 bo 4th hr. P/ 229 bopd.

Comp 40 bopd.

**COMPLETED**







