


Section 27 Township 15 Range 18W

Well No. 1 Ruder

Company Jones & Shelborne

Ruder Pool

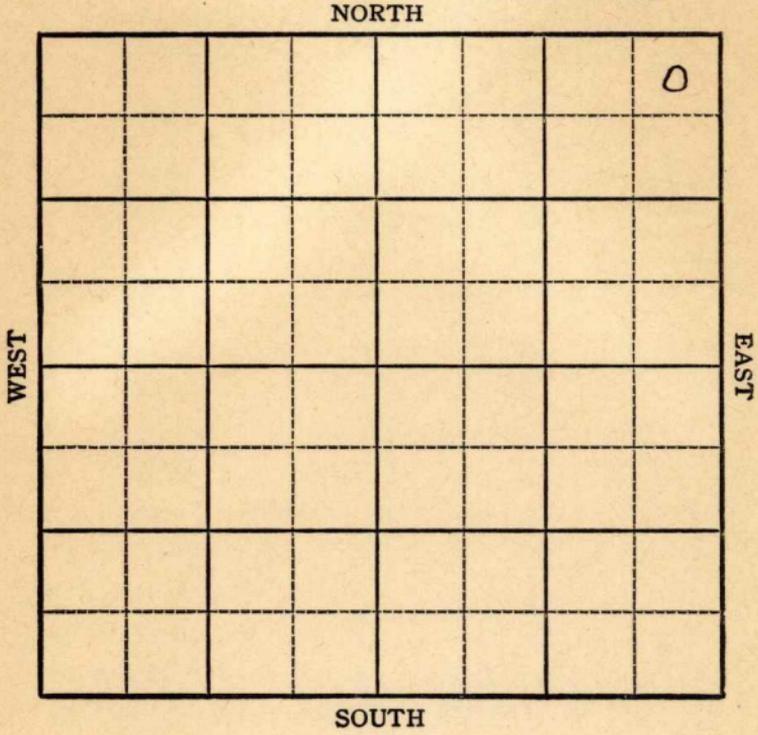

KANSAS

Ellis



Sec. 27 Twp. 15 R. 18W


Well No. #1 Ruder Farm

Jones & Shelborne Company

Ruder Pool

NORTH

330' Ft. from N. Line

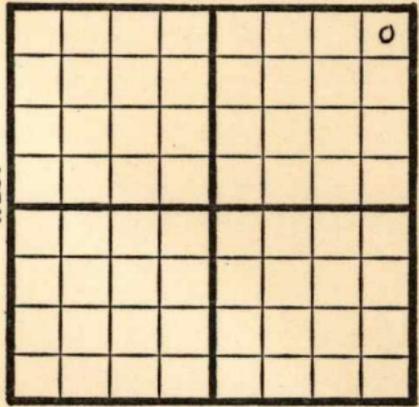

_____ Ft. from S. Line

330' Ft. from E. Line

_____ Ft. from W. Line

NE/C

SOUTH

1948

Elev. 2005'

REPORT

8/18

8" @ 202'

WOC

8/25

D rlg 2777'

9/1

Lansing 3279'

BKC 3228'

Arbuckle 3571'

TD 3583'

5" @ 3574'

9/8

Arb 3571'

5" @ 3574'

TD 3590'

500 acid

Pump 50 oil Pot.

Gr. 36°

COMPLETED

Ellis County Kansas State

Map No. Sec. 27 Twp. 15 R. 18W


Well No. 1 Ruder

Jones & Shelborne Company

FIRST REPORT Contractor

NE/C

SECTION PLAT

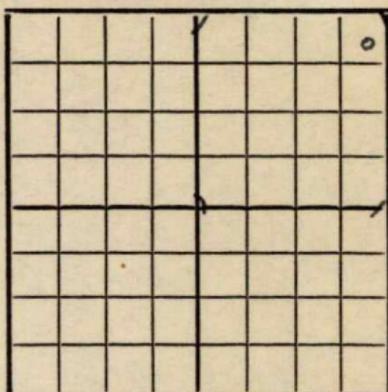

330 Ft. from N. Line

Ft. from S. Line


330 Ft. from E. Line

Ft. from W. Line

Ruder Pool

Remarks:

8" @ 202 WOC

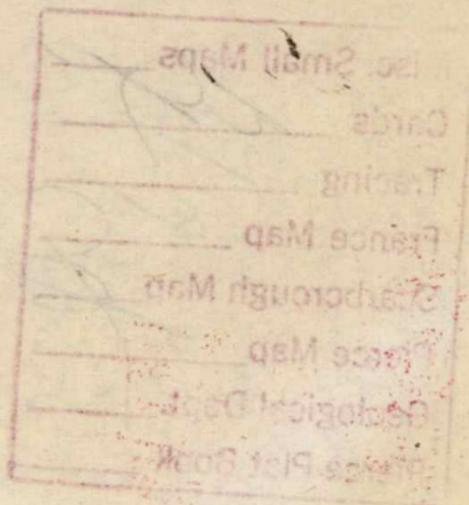

Date AUG 1 8 1948

Scout S. J. LEWIS

Ellis County Kansas State

Map No. 74 Sec. 27 Twp. 15 R. 18W

Well No. 1 Ruder

Jones & Shelborne Company

COMPLETE Contractor

NE/C

E. 2005
SECTION PLAT

330 Ft. from N. Line

 Ft. from S. Line

330 Ft. from E. Line

 Ft. from W. Line

									8

Ruder Pool

Remarks:

Arx 3571


5" 03574

ND 3590

500 acid

Only soil by

960

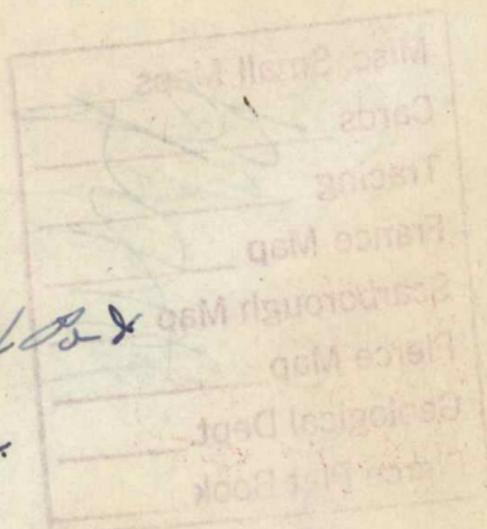

Date SEP 8 1948

Scout S. J. LEWIS