
KANSAS

FORM 51 Ellis

Section 31 Township 13 Range 17W

Well No. #1 Weisner

Company Fleming & Woodman

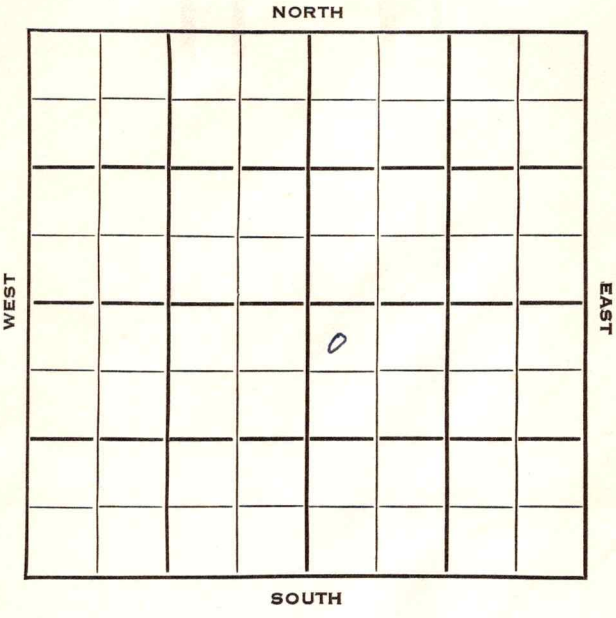

FORM 252-B

Ellis KANSAS ✓

Sec. 31 Twp. 13 R. 17 W

Well No. # 1 Weisner Farm

Fleming & Woodman Company

Contractor

Wildcat


330 Ft. from N. Line

Ft. from S. Line

Ft. from E. Line

330 Ft. from W. Line

NW NW SE

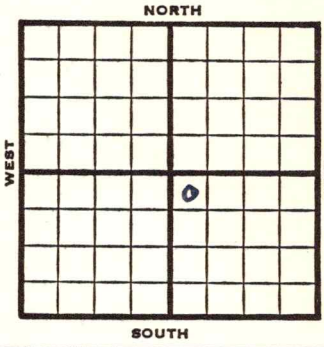

1953	REPORT
	Elev. 2045'
2/18	Spud 2-11-53 8" @ 137 Anhy 1262' Drlg. 2680'
2/25	Spud ~~XX~~ 2-11-53 D & A TD 3673 8" @ 137 Anhy 1262 Heeb 3298 Tor. 3319 Lans. 3342' Cong 3578 Arb. 3599 TD 3673 D & A

ABANDONED

3319 / 2045 / 126

3342 / 2045 / 129

3578 / 2045 / 153

3599 / 2045 / 154

FORM 275 FOR SALE BY KANSAS BLUE PRINT CO.


County Ellis State Kansas

Sec. 31 (Blk. Twp.) 13 (Sur. Rge.) 17W Map No.

Operator Fleming & Woodman

Well No. 1 Farm Weisner

Elev. 2045 Location NW NW SE

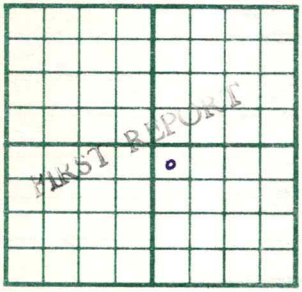

330 Ft. From N Line SE

330 Ft. From W Line Quarter

1st. Report FEB 18 1953

Completion

Remarks

Spudding Date 2-11-53

Drlg. Data Wildcat

8" @ 137 Anhy 1262 drlg. 2680

J. G. McGEHEE

FORM 275 FOR SALE BY KANSAS BLUE PRINT CO.


County Ellis State Kansas

Sec. 31 (Blk. Twp.) 13 (Sur. Rge.) 17W Map No.

Operator Fleming & Woodman

Well No. 1 Farm Weisner

Elev. 2045 Location NW NW SE

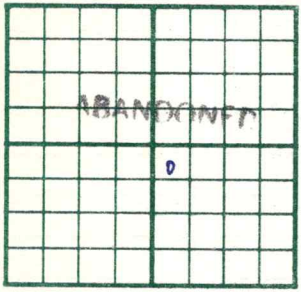

330 Ft. From N Line SE

330 Ft. From W Line Quarter

1st. Report

Completion FEB 25 1953

Remarks

Spudding Date 2-11-53

Drlg. Data D & A TD 3673

8" @ 137 Anhy 1262 Heeb. 3298

Tor. 3319 Lans. 3342 Cong. 3578

Arb. 3599 TD 3673

D & A

J. G. McGEHEE