


Section 1 Township 33 Range 1E

Well No. #5 Fulghum (Fulghum)

Company J.B. O'Quinn

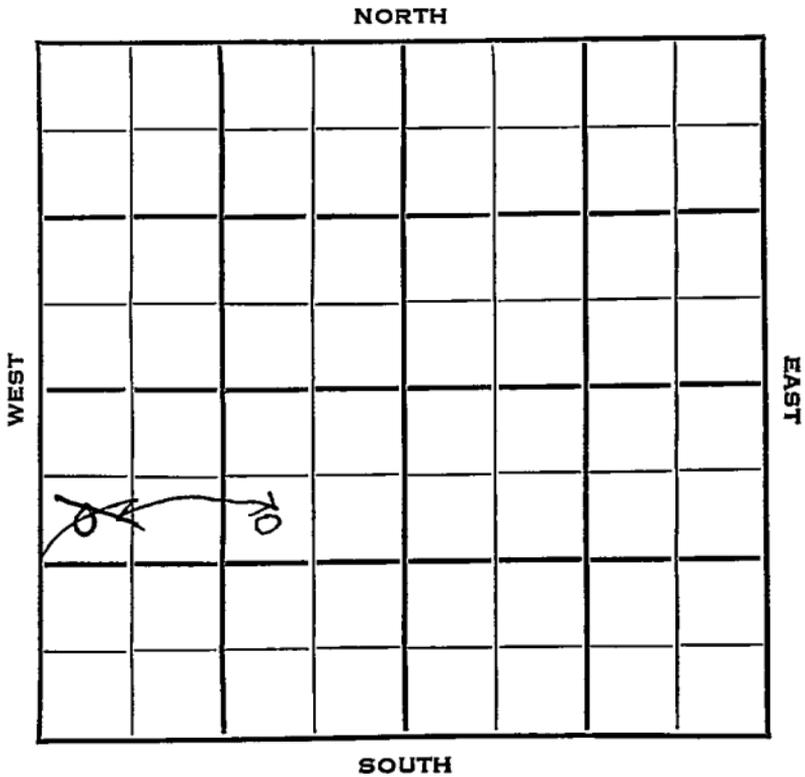

Cowley

KANSAS

SEC.	TWP.	R.
1	33	4E

WELL NO
5 Fulgrom FARM

COMPANY

CONTRACTOR
J. B. O'Quinn


Criswell
Tisdale Gas Pool

~~990-1040~~ Ft. from N. Line

_____ Ft. from S. Line

_____ Ft. from E. Line

~~330-1350~~ Ft. from W. Line

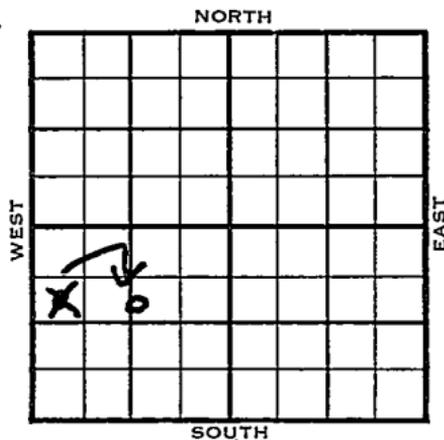

~~SW NW SW~~
SW NE SW

1953	ELEVATION	REPORT
	1224'	

9/23
12/16

Cellar & Pits
Spud 10-10-53
Oil Well
TD 1759'
8" @ 90'
Hoover 1737',
5" @ 1737'
TD 1742'
DD 1759'
sd-oil-frac S/ 10 boph
Comp 53 bopd.

COMPLETED

Kansas

Map No. _____ Sec. 1 Twp. 33 R. 4E

Well No. 5 Fulcrum

J. B. O'Quinn Company

CORRELATION Contractor

SW NE SW


SECTION PLAT

1040 Ft. from N. Line

_____ Ft. from S. Line

_____ Ft. from E. Line

1350 Ft. from W. Line

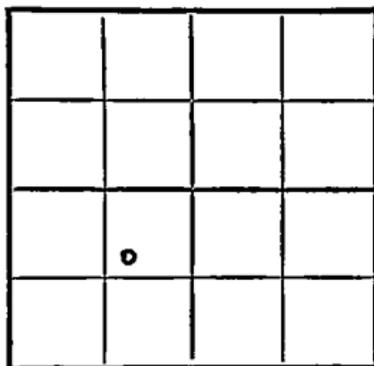

Cowley County

Location _____

Rig up _____

Drilling and Remarks:

Reported

SW NW SW

RECORD

Cased _____ in., _____ ft.

Sand _____

Gas _____

Oil _____

Total Depth _____

PRODUCTION

1st 24 hrs. Nat. _____

1st 24 hrs. after shot _____

Gas _____ Cu. Ft.

Dry Hole _____

Abandoned _____

Date

P 3 0 1953

19

J. G. McGEHEE

Scout

