



Sec. 32 Twp. 13 R. 17 W

Well No. # 2 Dinkel Farm

Ben Brack Oil Company

Ben Brack Contractor

Younger Pool


 Ft. from N. Line

990 Ft. from S. Line

 Ft. from E. Line

330 Ft. from W. Line

NW SW SE

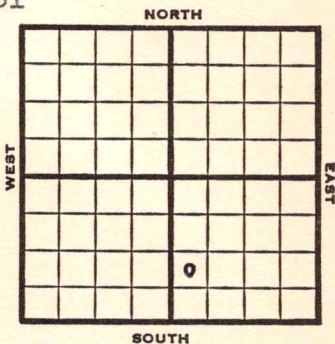

1953

Elev. 2035'

REPORT

6/17

Location

6/24

8" @ 190 Anhy 1250
Drlg. 2515'

7/1

KC 3307
DST 3330-45, 1 hr., 30' oil, 60' OCM, 435#
DST 3352-63, 1 hr., 600' gas, 60' OCM 45' OCW & M 580#

Arb 3561
RTD 3562
5" @ 3561

7/8

CO 3538
elec. log. 21/ 3357-62 16/ 3358-62
B/ 1 1/2 bo / 1/2 Bbl S/ 70 Bf 95% w. S/7
bfph 95% wtr.

7/22

NR

9/16

NR

IER

725210

1953
9/23

Spud 6-16-53

D&A

TD 3615'

8" @ 190'

Anhy 1250', KC 3307'

DST 3330-45', opn 1 hr., rec. 30'
oil, 60' ocm, 435#

DST 3352-63', opn 1 hr., rec. 600'
gas, 60' ocm, 45' ocw & mud, 580#

Arb. 3561'

TD 3562'

5" @ 3561'

CO to 3538'

21/3357-62, 16/3358-62

B/½ bo ½ bw

S/70 bf 95% wtr.

S/7 bfph95% wtr.

CO to 3371'

8/3336-40, 12/3340-42 1000A

S/17 bw ¼ boph

SP 3328

24/3311-15, 500A

3½ bwph

CO to 3562

DD 3615'

D&A

ABANDONED

