

Ellis

**KANSAS**

SECTION 28 TOWNSHIP 15 RANGE 18 W

WELL NO. #1 Herklatz

COMPANY Osage Oil

NORTH

				0			

WEST

EAST

SOUTH

Ellis

KANSAS

SEC. 28	TWP. 15	R. 18W
------------	------------	-----------

WELL NO. #1 Herklatz FARM

COMPANY Osage Oil

CONTRACTOR Trans-Era


**WILDCAT**

\_\_\_\_\_ Ft. from N. Line

\_\_\_\_\_ Ft. from S. Line

\_\_\_\_\_ Ft. from E. Line

\_\_\_\_\_ Ft. from W. Line

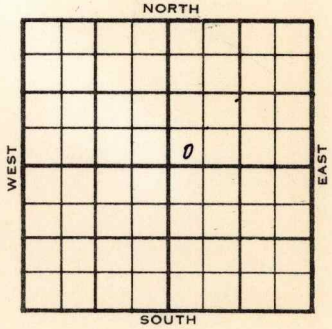

SW SW NE

1955	ELEVATION	REPORT
------	-----------	--------

12-14 Loc.



Name Ellis Date 1934  
 No. 28 Day 15 Age 16W  
 Company Osage Oil  
 Form Name Herklets No. 1

	TOPS	DEPTH	LOG	DATUM	Loc. in Sec.
Am.					SW SW NE
Tr.					
H.					
Tc.		3127		1253	
Dc.					
Bl.					
L.	✓	3213		1279	Geol.
Kc.					
Bcc.					Contr.
Cc.					Trans-Era
C.	<i>red as 3444</i>			1510	<i>Discovery</i> Schoenchen Pool <i>Towasite</i>
M.					Wildcat
M.					
K.					
M.					
No.					
V.					
S.					
S.					
A.					
R.					
Pe.					
G.					COMPLETE
30		3520 26			

Date Comm.

FEB 22 1956

Location DEC 21 '55 12-13-55

8 7/8 1090 Ø 2020 DEC 28 '55

DST 3216-43 90" rec. 140'

MW + 35' Md BHP 1060/20

Ø 3261 JAN 5 '56 DST 3260-61

1 1/2" rec. 270' oil BHP 1100

120 DST 3262-3300 1 1/2"

rec 25' Ø Md BHP 1801

5 1/2" Ø 2020 JAN 11 '56 5 1/2" 33301

OVER

JAN 18 '56 MICT CO 20/3256-61 &  
4 1/2 Bopk nslw 16 hrs 6 1/2 hrs  
& 31 Bopk nslw 12 hrs Pap  
JAN 25 '56 FEB 1 '56 FEB 8 '56 P. 50 Bopd  
+ 15% wtr FEB 15 '56 W0 POT FEB 22 '56  
Ph 123 Bopd + 23% wtr

R.C.

MAR 1 1956

CONFIDENTIAL