


Section 3 Township 14 Range 14-W

Well No. #~~6~~ Tee "C"

Company A. H. Witt

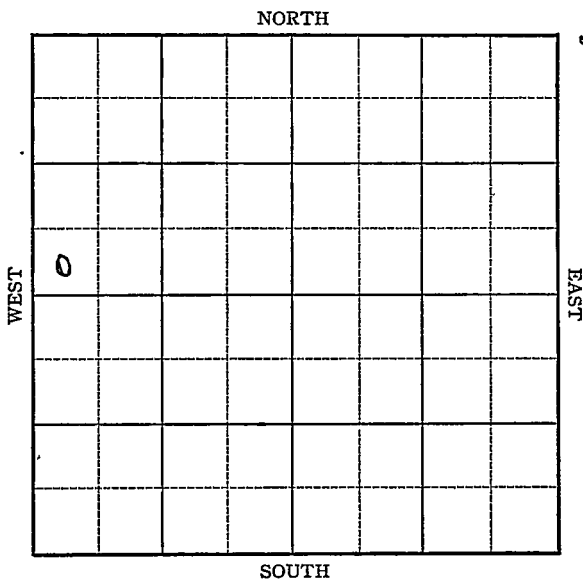


Sec. 3 Twp. 14 R. 14-W

Well No. #6 Fee "C" Farm

A. H. Witt Company

NORTH

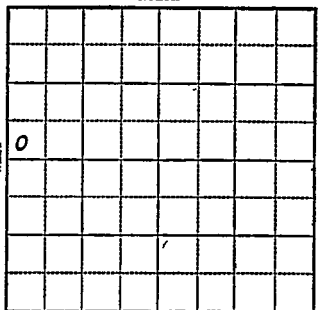

_____ Ft. from N. Line

330 Ft. from S. Line

_____ Ft. from E. Line

330 Ft. from W. Line

Elev. 1234

1943

R E P O R T

5/19

Location

5/26

"

6/2

Cable rig.

6/9

Spud

6/16

15" @ 319'

12" @ 522'

Anhy 825'

10" @ 825 WOC.

6/23

Drlg. 1615'

6/30

2350' Run 8"

7/7

8" @ 2635

Topeka 2695

SSO

S free oil 2687-90 Drlg.

7/15

Lans 2981-82 T.D.

SD for pipe

8/21

" " "

7/28

7" @ 2982'

8/4

T.D. 3004'-1000' oil

T.D. 3007-3000 acid

8/11

" " "

8/18

" " "

OVER

Map No. KANSAS 72 Sec. 3 Twp. 14 R. 14W

Well No. 6 Fee "G"

A. H. Witt Company

FIRST REPORT

Contractor

SW NW

SECTION PLAT

_____ Ft. from N. Line

330 Ft. from S. Line

_____ Ft. from E. Line

330 Ft. from W. Line

WITT POOL

Location XXX

Rig up _____

Drilling and Remarks:

RECORD

Cased _____ in., _____ ft.

Sand _____

Gas _____

Oil _____

Total Depth _____

PRODUCTION

1st 24 hrs. Nat. _____

1st 24 hrs. after shot _____

Gas _____ Cu. Ft.

Dry Hole _____

Abandoned _____

Date

MAY 1 9 1943

19

S. J. LEWIS.

Scout

Russell

KANSAS

Map No. 72 Sec. 3 Twp. 14 R. 14W

Well No. 6 Fee "C"

A. H. Witt Company

COMPLETED Contractor

SW NW

SECTION PLAT

 Ft. from N. Line

330 Ft. from S. Line

 Ft. from E. Line

330 Ft. from W. Line

Witt Pool

6			

Location

Rig up

Drilling and Remarks:

Law 2981
7" @ 2982
3000 acid
Pump 415 Pst.
412 Gr

RECORD

Cased in., ft.

Sand

Gas

Oil

Total Depth 3007

PRODUCTION

1st 24 hrs. Nat.

1st 24 hrs. after shot

Gas Cu. Ft.

Dry Hole

Abandoned

Date

AUG 25 1943

19

S. J. LEWIS Scout

1943
8/25

Lans 2981
7" @ 2982
3000 acid
Pump 415 Pot.
T.D. 3007'
Grav. 41.7

COMPLETED