

Map No. **KANSAS**Sec. **3**Twp. **14**R. **14W**Well No. **1-Clark**

Farm

Company **Hutchinson Oil Co.**

NORTH

WEST

EAST

SOUTH

Location _____

Drilling Remarks _____

Rig Up _____

Drilling Remarks _____

RECORD

Cased _____ in. _____ ft.

Sand _____

Gas _____

Oil _____

Total Depth _____

PRODUCTION

1st 24 hrs. Nat. _____

1st 24 hrs. after shot _____

Gas _____ cu. ft. _____

Dry Hole _____

Abandoned _____

Russell

Map No. KANSAS Sec. 3 Twp. 14 R. 14W


Well No. 1-Clark Farm
Hutchinson Oil Co. Company

330 Ft. from N. Line

_____ Ft. from S. Line

_____ Ft. from E. Line

330 Ft. from W. Line

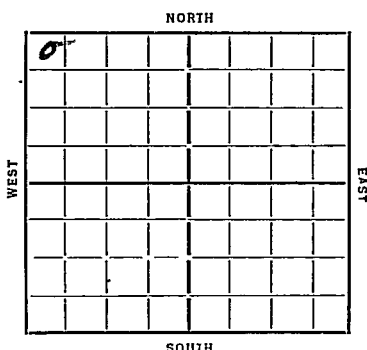

Date

REPORT

1935
3/20 Location
3/28 Rig
4/4 15 1/2 315
4/11 12" 500 10" 875 Aubrey 850
4/18 Alg 2255
4/26 Alg 2900
5/2 Oswald 3010 6" 3004
HFV 3170 Alg 3180
5/9 5" 3303 Sil 3309-11
5/15 Siliceous 3309 T 3313
17.0 ft.

ABANDONED

Map No. 72 Sec. 3 Twp. 14 R. 14WWell No. 1-ClarkHutchinson Oil Co. Company

Contractor

FIRST REPORTS

SECTION PLAT

330 Ft. from N. Line

Ft. from S. Line

Ft. from E. Line

330 Ft. from W. Line

0			

Location ✓

Rig up

Drilling and Remarks:

RECORD

Cased in., ft.

Sand

Gas

Oil

Total Depth

PRODUCTION

1st 24 hrs. Nat.

1st 24 hrs. after shot

Gas Cu. Ft.

Dry Hole

Abandoned

Date

ORVAL MANNSCHRECK

3-20-35 192

Scout

Map No. 72 Sec. 3 Twp. 14 R. 14WWell No. 1-ClarkHutchinson oil Company

Contractor

ABANDONED

SECTION PLAT

330 Ft. from N. Line

Ft. from S. Line

Ft. from E. Line

330 Ft. from W. Line

0			

Location

Rig up

Drilling and Remarks:

10+ 17

RECORD

Cased in., ft.

Sand Silicurns 3309

Gas

Oil

Total Depth 3313

PRODUCTION

1st 24 hrs. Nat.

1st 24 hrs. after shot

Gas Cu. Ft.

Dry Hole

Abandoned

ORVAL MANNSCHRECK

Date

5-13-35 192 Scout