

O.W.W.O.

FORM 51 10M 8-47


KANSAS

Ellis

Section 32 Township 13 Range 17W

Well No. #2 Hoffman

Company Ben Brack

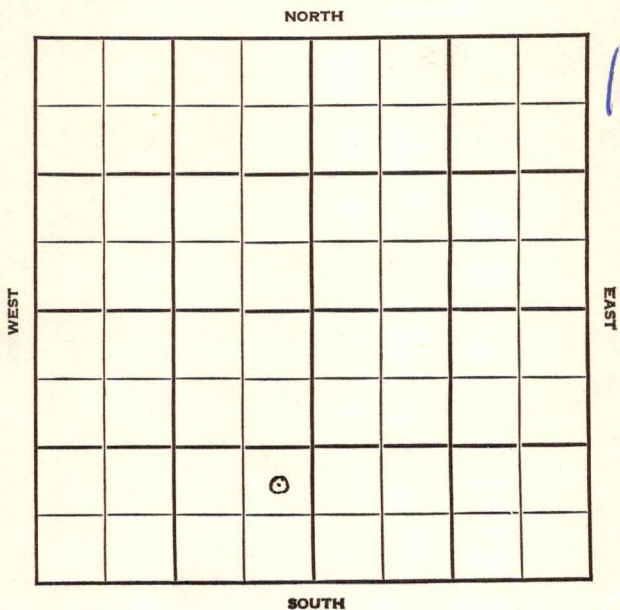

O.W.W.O.

KANSAS Ellis

Sec. 32 Twp. 13 R. 17W

Well No. #2 Hoffman Farm

Ben Brack

Company

Younger


 Ft. from N. Line

990 Ft. from S. Line

330 Ft. from E. Line

 Ft. from W. Line

NE SE SW

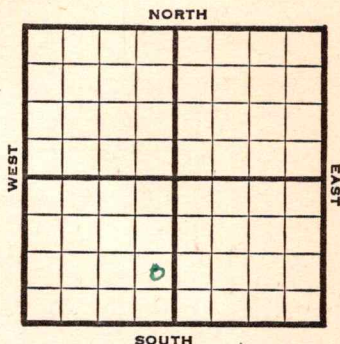

1948	Elev. 2033'	REPORT
1/14	RUR	
1/21	8" @ 215' Drlg. 2518'	
2/26	Lansing 3299' Arbuckle 3578'-57' TD 3557' 5" @ 3550' RUST	
2/4	Bail 2½ bailers oil PH	
2/11	TD 3582' 3000 acid No help	
2/18	TD 3596' SWB 21½ bbls Oil PH	
2/25	1000 Acid Pump 2½ bbls oil PH, 3 hrs.	
3/3	"	
3/10	Arbuckle 3548' 5" @ 3550' 4000 Acid Pump 79 Pot. Gr. 270 TD 3596'	

COMPLETED

OVER

725223

1953

3/25

O.W.W.O.

Lans. 3299'

Arb. 3548'

5" @ 3550

OTD 3582'

To PB

4/2

To PB

4/9

"

4/16

"

4/23

"

4/30

"

5/7

"

5/21

"

5/28

"

6/3

"

6/10

Oil Well

TD 3582'

Lans 3299', Arb 3548',

5" @ 3550'

OTD 3582'

PB & test KC wtr. sq.

CO to 3582

Comp 45 bopd.

3299
2033
1266

COMPLETED

3548
2033
1515

Map No. _____ Sec. 32 Twp. 13 R. 17W

Well No. 2 Hoffman

Ben Brach Company

FIRST REPORT Contractor

NE SE SW


SECTION PLAT

_____ Ft. from N. Line

990 Ft. from S. Line

330 Ft. from E. Line

_____ Ft. from W. Line

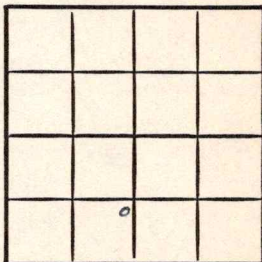

Ellis County

Location _____

Rig up _____

Drilling and Remarks:

R U R

RECORD

Cased _____ in., _____ ft.

Sand _____

Gas _____

Oil _____

Total Depth _____

PRODUCTION

1st 24 hrs. Nat. _____

1st 24 hrs. after shot _____

Gas _____ Cu. Ft.

Dry Hole _____

Abandoned _____

Date

JAN 14 1948

19

S. J. LEWIS

Scout

Map No. 71 Sec. 32 Twp. 13 R. 17W

Well No. 2 Hoffman

Ben Brach Company

COMPLETE

Contractor

NE SE SW

E. 2033

SECTION PLAT

 Ft. from N. Line

990 Ft. from S. Line

330 Ft. from E. Line

 Ft. from W. Line

Ellis County

Location

Rig up

Drilling and Remarks:

Cr 1548
5" @ 358
4000 ac in

Pump 19 Pa X

27 1/2

RECORD

Cased in., ft.

Sand

Gas

Oil

Total Depth 3596

PRODUCTION

1st 24 hrs. Nat.

1st 24 hrs. after shot

Gas Cu. Ft.

Dry Hole

Abandoned

Date

MAR 10 1948

19

S. J. LEWIS

Scout

O.W.W.O.

County Ellis State Kansas
 Sec. 32 (Blk.) 13 (Sur.) 17W Map No. (Twp.) (Rge.)
 Operator Ben Brack
 Well No. 2 Farm Hoffman
 Elev. 2033 Location NE SE SW



990 Ft. From S Line SW
330 Ft. From E Line Quarter

1st. Report

Completion JUN 10 1953

Remarks

OWVO

O.W.W.O.

Spudding Date

Drlg. Data Oil well TD 3582
Lans. 3299 Arb. 3548 5" @ 3550
OTD 3582 PB & test KC wtr. sq.
CO to 3582 Comp. 45 bopd

J. G. McGEHEE