


Section 1 Township 33 Range 4E

Well No. 1 Graham

Company Rooks Hall

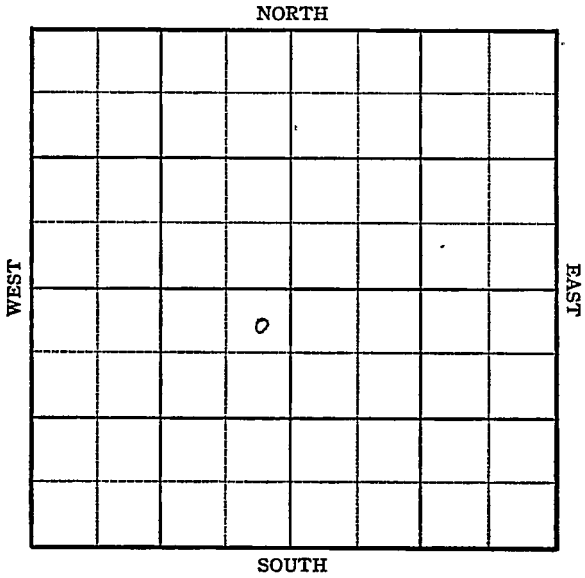

Sec. 1 Twp. 33 R. 4-E

Well No. #1 Graham Farm


Rooks Hall Company

330 Ft. from N. Line

_____ Ft. from S. Line

330 Ft. from E. Line

_____ Ft. from W. Line

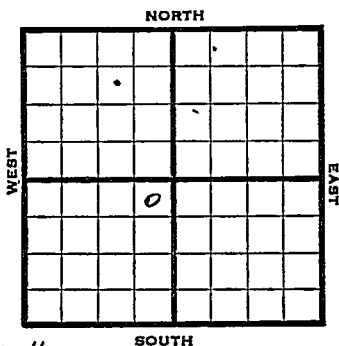

NE SW *... Twin Well*

1945 Elev. 1222' REPORT

10/17	Location
10/24	15" @ 435 Drlg. 600
10/31	12" @ 1210 Drlg.
11/7	10" @ 1607 Drlg. 1650
11/14	8" @ 2025 Drlg. 2030'
11/21	Drlg. 2345 8" @ 2055'
11/28	Stal 2000-2345 UR- 8"
12/5	8" @ 2430 Drlg. 2500
12/12	8" @ 2481 KC 2750 Drlg. 2840
12/20	Chat 3100' T.D. SD for csg.
12/29	" " "
1946	
1/10	TD 3128' 6" - 3107'
1/17	T.D. 3137' 500 acid. SS/oil.
1/24	" "
1/31	1000 acid.
2/7	" "
2/14	" "
2/21	" "
2/28	" "
3/7	" "
3/14	" "
3/21	" "

OVER

1946
3/28 T.D. 3137'
1000 acid.

4/4 " " "

4/10 " " "

4/16 " " "

4/23 " " "

5/1 Chat 3100
6" @ 3107
1500 acid.
TD 3137'

ABANDONED

KANSAS

Kansas Pool Name Miscellaneous

Map No. 2 Sec. 1 Twp. 33 R. 4E

Well No. 1 Graham

Rooks Hall Company

FIRST REPORT

Contractor

NE SW

SECTION PLAT

330 Ft. from N. Line

_____ Ft. from S. Line

330 Ft. from E. Line

_____ Ft. from W. Line

Cowley County

Location X

Rig up _____

Drilling and Remarks:

*Turn
oil
well
250
250*

RECORD

Cased _____ in., _____ ft.

Sand _____

Gas _____

Oil _____

Total Depth _____

PRODUCTION

1st 24 hrs. Nat. _____

1st 24 hrs. after shot _____

Gas _____ Cu. Ft.

Dry Hole _____

Abandoned _____

Date

OCT 17 1945 19

S. J. LEWIS

Scout

well #1 producer on this spot.
(Gayman, et al) CCB

Misc Small Maps	CCB
Cards	CCB
Tracing	CCB
France Map	CCB
Scarborough Map	CCB
Pierce Map	CCB
Geological Dept.	
Pierce Plat Book	

KANSAS

Kansas Pool Name Miscellaneous

Map No. 2 Sec. 1 Twp. 33 R. 4E

Well No. 1 Graham

Rooks Hall Company

ABANDONED Contractor

NE SW

E 1/222
SECTION PLAT

330 Ft. from N. Line

 Ft. from S. Line

330 Ft. from E. Line

 Ft. from W. Line

Cowley County

Location _____

Rig up _____

Drilling and Remarks:

Chas 8100
6" 08/07
wood acid

RECORD

Cased _____ in., _____ ft.

Sand _____

Gas _____

Oil _____

Total Depth 3137

PRODUCTION

1st 24 hrs. Nat. _____

1st 24 hrs. after shot _____

Gas _____ Cu. Ft.

Dry Hole _____

Abandoned _____

Date

MAY 1 1946

19

S. J. LEWIS

Scout