

Section 32 Township 13 Range 17W

Well No. #1 Lang

Company Ben Brack

NORTH

0							

4

WEST

EAST

SOUTH

Ellis

KANSAS

Sec. 32 Twp. 13 R. 17W

Well No. #1 Lang Farm

Ben Brack

Company

Contractor

Younger Pool


330' Ft. from N. Line

Ft. from S. Line

Ft. from E. Line

330' Ft. from W. Line

NW NW NW

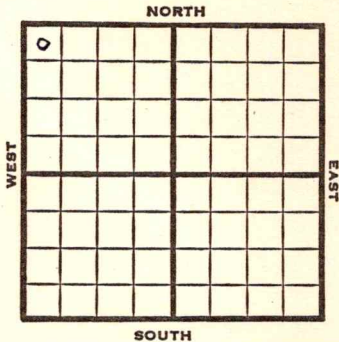

1951 **Elev. 2047'** REPORT

6/13 Cellar & pits

7/11 Spud 6-15-51
D&A TD 3660
8" @ 319

Anhy 1305 Heeb. 3302

Dodge 3321 Lans. 3343

DST 3385-95 opn 1/2 hr.

Rec. 55' wtr & mud

SO 3368-75 3388-94 3437-43

DST 3432-47 opn 25 min Rec. 15'

mud Marm. 3580 TD 3660

Cong. 3587 D&A

ABANDONED

3343
2047
1296

3587
2047
1540

3660
2047
1613

County **Ellis** State **Kansas**

Sec. **32** (Bik. Twp.) **13** (Sur. Rge.) **17W** Map No.

Operator **Ben Braak**

Well No. **1** Farm **Lang**

Elev. Location **NW NW NW**

0							

FIRST REPORT

330 Ft. From **N** Line **NW**

330 Ft. From **W** Line **Quarter**

1st. Report **JUN 13 1951**

Completion

Remarks

Carter - F.O.

Spudding Date

Drlg. Data

Cellar & pits **Younger Pool**

County Ellis State KAUSS

Sec. 32 (Blk. 13 (Sur. 17W Map No. (Twp.) Rge.)

Operator Ben Brack

Well No. 1 Farm Lang

Elev. 2047 Location NW NW NW

0					

ABANDONED

330Ft. From N Line NW

330Ft. From W Line Quarter

1st. Report

Completion JUL 11 1951

Remarks Younger Pool

Spudding Date 6-15-51

Drig. Data D & A TD 3660

8" @ 319 Anhy 1305 Heeb. 3302

Dodge 3321 Lans. 3343 DST 3385-95

open 1/2 hr. Rec. 55' water & mud

S0 3368-75 3388-94 3437-43

DST 3432-47 open 25 min. Rec. 15'

mud Marm. 3580 TD 3660 Cong. 3587

D & A

J. E. TYRA