

Russell KANSAS

Sec. 4 Twp. 14 R. 14W

Well No. #5 Krug "A" Farm _____

C R A Company _____

Contractor _____


Hall-Gurney Pool

_____ Ft. from N. Line

990' Ft. from S. Line

990
330' Ft. from E. Line

_____ Ft. from W. Line

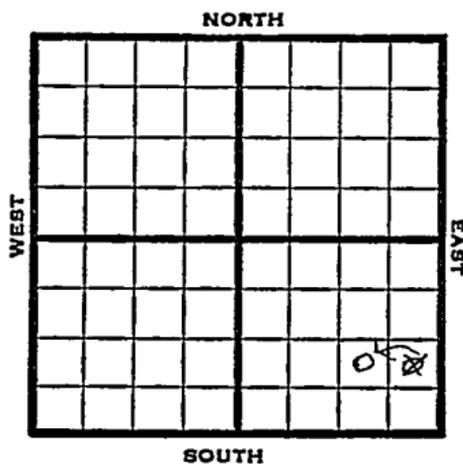

~~NE SE SE~~

nw se se

1950

Elev 1837

REPORT

4/26 Rig up

5/17 TD 3250
 8 5/8" @ 837
 Tonkio 2424
 Topeka 2700
 Heeb 2934
 Lans 2982
 Sand 3245-48
 5" @ 3246
 P81 BOPD 65% wtr
 Completed

COMPLETED

Kansas

Hall-Gurney Pool

Map No. _____ Sec. 4 Twp. 14 R. 14WWell No. 5 Krug "A"

_____ CRA _____ Company

_____ Contractor

NE SE SE

SECTION PLAT

			0

_____ Ft. from N. Line

990 Ft. from S. Line330 Ft. from E. Line

_____ Ft. from W. Line

Russell County

Location _____

Rig up _____ X _____

Drilling and Remarks:

RECORD

Cased _____ in., _____ ft.

Sand _____

Gas _____

Oil _____

Total Depth _____

PRODUCTION

1st 24 hrs. Nat. _____

1st 24 hrs. after shot _____

Gas _____ Cu. Ft.

Dry Hole _____

Abandoned _____

Date

APR 26 1950 19J. E. TYRA Scout

Map No. _____ Sec. 4 Twp. 14 R. 14W

Well No. 5 Krug "A"

C R A Company

CORRECTION

Contractor

NW SE SE

SECTION PLAT

_____ Ft. from N. Line

990 Ft. from S. Line

990 Ft. from E. Line

_____ Ft. from W. Line

			o

Russell County

Location _____

Rig up _____

Drilling and Remarks:

Reported

NE SE SE

RECORD

Cased _____ in., _____ ft.

Sand _____

Gas _____

Oil _____

Total Depth _____

PRODUCTION

1st 24 hrs. Nat. _____

1st 24 hrs. after shot _____

Gas _____ Cu. Ft.

-Dry Hole _____

Abandoned _____

Date

MAY 3 1950 19

J. E. TYRA Scout

Kansas

Map No. _____ Sec. 4 Twp. 14 R. 14W

Well No. 5 Krug "A"

C R A Company

NW SE SE El. 1837 Contractor


SECTION PLAT

_____ Ft. from N. Line

990 Ft. from S. Line

990 Ft. from E. Line

_____ Ft. from W. Line

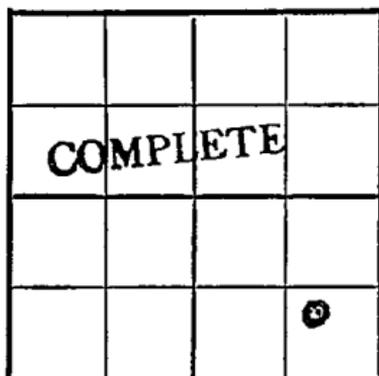

Russell

Location _____

Rig up _____

Drilling and Remarks:

8 5/8" @ 837

Jarkio 2424

Jopeka 2700

Hub 2934

Lens 2982

Sand 3245-48

5" @ 3246

Date P 81 BOPD

MAY 17 1959

RECORD

Cased _____ in., _____ ft.

Sand _____

Gas _____

Oil _____

Total Depth 3250

PRODUCTION

1st 24 hrs. Nat. _____

1st 24 hrs. after shot _____

Gas _____ Cu. Ft.

Dry Hole _____

Abandoned _____

65% Water.

J. E. TYRA Scout