

Form 11-51 3-14-53
O.W.P.C. 1-14-53

Barton


KANSAS

O.W.P.B. 11-12-52

Section 18 Township 16 Range 13-W

Well No. 1 Bitter "C"

Company Cities Service Oil *Inc*

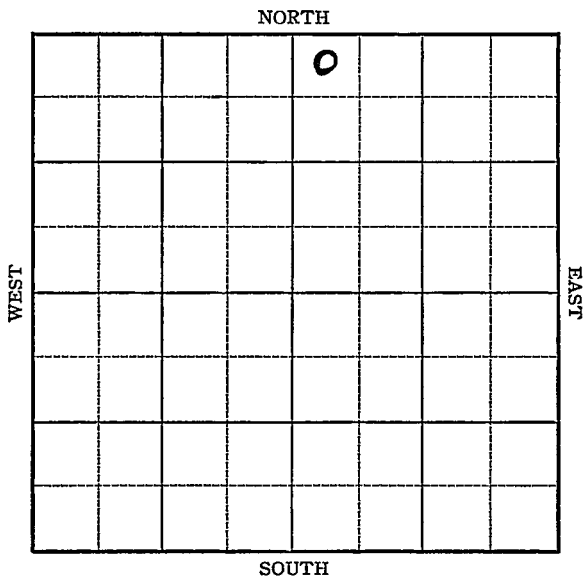

O.W.P.D. KANSAS Barton **KANSAS** ✓
O.W.W.O. 1-14-53
 Sec. 18 Twp. 16 R. 13-W

Well No. #1 Bitter "C" Farm

Cities Service Oil Company


330 Ft. from N. Line

 Ft. from S. Line

 Ft. from E. Line

330 Ft. from W. Line

NW NW NE Elev. 1933

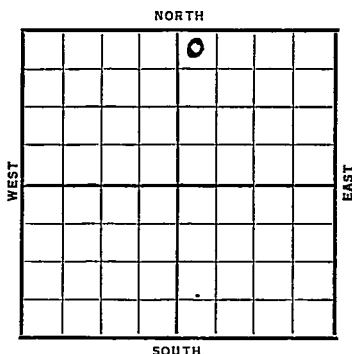

Date

REPORT

1937

11/10 B. R. R.

11/19 S.D. 400'.

11/26 " "

12/3 10" @ 412'. Drlg. 2065'.

12/10 K.C. 3132'. Coring 3149'.

12/17 S.O. 3132-49'. Sil. 3372'.

7" @ 3373' S.O. RUST.

12/24 T.D. 3389'. 2180' oil.

12/31 Bldg. tanks.

1938

1/7 2000 acid.

1/12 7" @ 3373'.

Arb. 3372'.

T.D. 3389'.

2000 acid.

Potential 518 oil.

Cutting 1½% water.

COMPLETED

OVER

1952

O. W. P. B.

11/12 D&A TD 3389
Lans. 3113 Arb. 3372
7" @ 3373 OTD 3389 PB 3301
36/ 3211-21 1000 A 16 gwph
14 hr. PB 3167 54/ 3131-48
1000 A wtr. D&A

FIRST REPORT

ABANDONED

1953

O.W.W.O.

1/14 Oil well TD 3389' Lans. 3113'
Arb. 3372' OTD 3389' 7" @ 3373
PB 3073' 49/2980-94 16/2968-74
38/2956-68 2000 A
Comp. 26 BOPD 2 BW

FIRST REPORT

COMPLETED

Barton KANSAS

Map No. _____ Sec. 18 Twp. 16 R. 13W

Well No. 1 Bitter "C"

Cities Service Oil

Company

Contractor

FIRST REPORT

NW NE

330 Ft. from N. Line

_____ Ft. from S. Line

_____ Ft. from E. Line

330 Ft. from W. Line

SECTION PLAT

		0	

Location _____

Rig up _____

Drilling and Remarks:

BRR

RECORD

Cased _____ in., _____ ft.

Sand _____

Gas _____

Oil _____

Total Depth _____

PRODUCTION

1st 24 hrs. Nat. _____

1st 24 hrs. after shot _____

Gas _____ Cu. Ft.

Dry Hole _____

Abandoned _____

Date

NDV 10 1937 19

H. D. Hatfield

Scout

Map No. 73 Sec. 18 Twp. 16 R. 13WWell No. 1-Bitter "C"Cities Service Oil

Company

Contractor

COMPLETED

NW NE

SECTION PLAT

		0	

330 Ft. from N. Line Ft. from S. Line Ft. from E. Line330 Ft. from W. LineLocation Rig up

Drilling and Remarks:

*2000 acid**POT - 518 oil**cutting 1 1/2 gals water***RECORD**Cased 7 in., 3373 ft.Sand Arb 3372Gas Oil Total Depth 3389**PRODUCTION**1st 24 hrs. Nat. 1st 24 hrs. after shot Gas Cu. Ft.Dry Hole Abandoned

Date

JAN 12 1938 19H. D. Hatfield Scout

County **Barton** State **Kansas**
 Sec. **18** (Blk. Twp.) **16** (Sur. Rge.) **13W** Map No.
 Operator **Cities Service Oil**
 Well No. **1** Farm **Bitter "C"**
 Elev. **1933** Location **NW NW NE**

FIRST REPORT
ABANDONED

330 Ft. From **N** Line **NE**
330 Ft. From **W** Line **Quarter**
 1st. Report **NOV 12 1952**
 Completion **NOV 12 1952**
 Remarks **OWPB**
O. W. P. B.

Drilg. Data **D & A** **TD 3389**
Spudding Date

Lans. 3113 Arb. 3372 7" @ 3373

OTD 3389 PB 3301 36/ 3211-21 1000 A

16 bwph 14 hr. PB 3167 54/ 3131-48

1000 A wtr.

D & A

O.W.W.O.

County Barton State Kansas
 Sec. 18 (Blk. 16 (Sur. 13W Map No.
 (Twp.) (Rge.)
 Operator Cities Service Oil
 Well No. 1 Farm Bitter "C"
 Elev. 1933 Location NW NW NE

FIRST REPORT
COMPLETE

330 Ft. From N Line NE
330 Ft. From W Line Quarter
 1st. Report JAN 14 1953
 Completion JAN 14 1953
 Remarks O.W.W.O.

Spudding Date O.W.W.O.

Drig. Data Oil well TD 3389
Lans. 3113 Arb. 3372 OTD-3389-7" @ 3373
PB 3073 49/ 2980-94 16/ 2968-74
38/ 2956-68 2000 A
Comp. 26 bopd 2 bw

J. G. McGEHEE