


Section 17 Township 29 Range 6E

Well No. #10 Wakefield

Company Earl Wakefield

NORTH

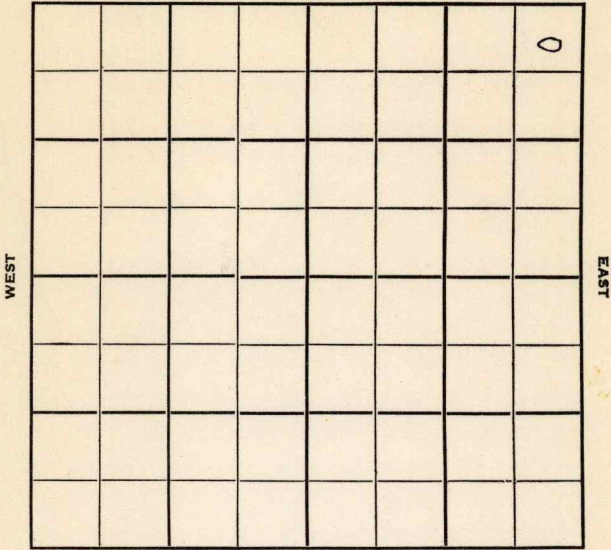

SOUTH

Butler

KANSAS

Sec. 17 Twp. 29 R. 6E ✓

Well No. #10 Wakefield Farm

Earl Wakefield Company

Contractor


330 Ft. from N. Line

Ft. from S. Line

330 Ft. from E. Line

Ft. from W. Line

NE NE NE

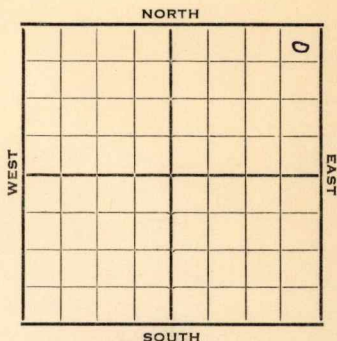

1952

Elev. 1404'

REPORT

3/5

8" @ 98'

Drlg. 1565'

5/7

Oil well TD 2498'

8" @ 98

KC 2154

Peru 2477

TD 2498 5" @ 2494' Hydro.

Comp. 25 bopd

COMPLETED



