


Section 1 Township 33 Range 4 E

Well No. # 1 Johnson

Company Eckland Drlg. Co.

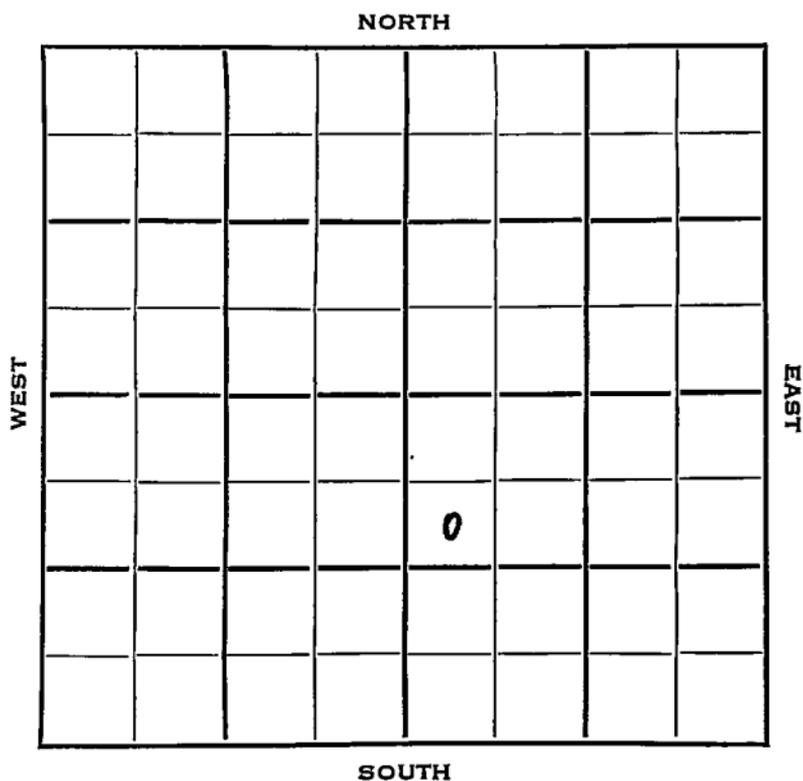

Cowley KANSAS

Sec. 1 Twp. 33 R. 4E

Well No. #1 Johnson Farm

Eckland Drlg. Co. Company


Winfield So. Contractor

990 Ft. from N. Line

\_\_\_\_\_ Ft. from S. Line

\_\_\_\_\_ Ft. from E. Line

330 Ft. from W. Line

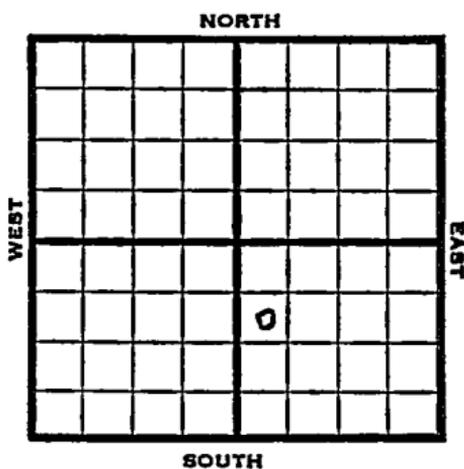

SW NW SE

1953

Elev. 1192' REPORT

7/22

C&P

12/2

Spud 7-26-53

D & A T 1802' 8" @ 62

Hoover 1737' TD 1802'

5" @ 1802 Perf 1741-45 sd-frac.

D & A

**ABANDONED**

County Cowley State Kansas

Sec. 1 (Blk.) 33 (Sur.) 4E Map No.

Operator Eckland Drlg. Co.

Well No. 1 Farm Johnson

Elev. \_\_\_\_\_ Location SW NW SE


990 Ft. From N Line SE

330 Ft. From W Line Quarter

1st. Report JUL '2 1953

Completion \_\_\_\_\_


Remarks \_\_\_\_\_

Spudding Date \_\_\_\_\_

Drlg. Data Winfield So.

C&P

J. G. McGEHEE

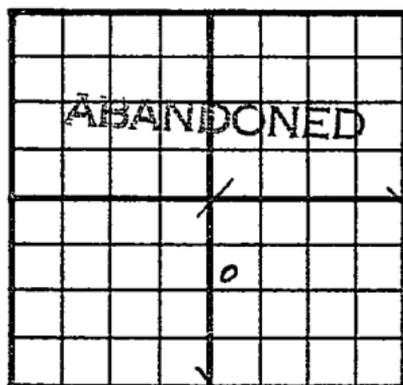County Cowley State KansasSec. 1 (Blk. Twp.) 33 (Sur. Rge.) 4E Map No.Operator Eckland Drlg.Well No. 1 Farm JohnsonElev. 1192 Location SW NW SE990 Ft. From N Line SE330 Ft. From W Line Quarter

1st. Report

Completion DEC 2 1953Remarks S. Winfield PoolSpudding Date 7-26-53Drlg. Data D & A TD 18028" @ 62 Hoover 1737 TD 18025" @ 1802 perf. 1741-45 sd-fracC D & A